

USE TYPEWRITER OR BALL POINT PEN-PRESS FIRMLY, PRINT CLEARLY.


WATER WELL RECORD
KSA 82a-1201-1215

OCB

Kansas Department of Health and Environment-Division of Environment (Water well Contractors) Topeka, Kansas 66620

1. Location of well: County Wallace Fraction NW 1/4 SW 1/4 SW 1/4 Section number 21 Township number T 15 S R 39 E Range number 39

2. Distance and direction from nearest town or city: 16N, 3 1/2W, 2N, 4W 3. Owner of well: Ernie Poe
Street address of well location if in city: 1/4 N of Selkirk, KS R.R. or street: RFD #1 - Box 34
City, state, zip code: Sharon Springs, KS 67758

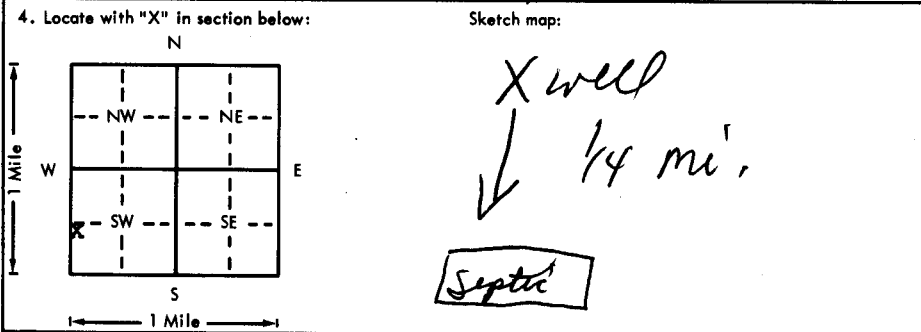

6. Bore hole dia. 26 in. Completion date _____
Well depth 222 ft. 4-26-75

7. Cable tool Rotary Driven Dug
 Hollow rod Jetted Bored Reverse rotary

8. Use: Domestic Public supply Industry
 Irrigation Air conditioning Stock
 Lawn Oil field water Other

9. Casing: Material Steel Height: Above or below
Threaded Welded Surface 10 in.
RMP PVC Weight 31.67 lbs./ft.
Dia. 16 in. to 222 ft. depth Wall Thickness: inches or
Dia. _____ in. to _____ ft. depth gage No. 188

5. Type and color of material	From	To
Clay	0	25
Gyp	25	35
Sdy clay	35	44
Sd coarse	44	51
Clay	51	57
Fine sd clay	57	100
Clay	100	111
Sd coarse	111	127
Clay	127	158
Sd rock	158	160
Clay	160	170
Fine sd clay	170	180
Sd coarse	180	186
Clay	186	195
Sd coarse	195	220
Yellow	220	223

10. Screen: Manufacturer's name _____
Free Flow
Type Prime Steel Dia. 16 1/2 in.
Slat gauge 125 Length 40 ft.
Set between 182 ft. and 222 ft.
_____ ft. and _____ ft.
Gravel pack? Yes Size range of material 3/4 - 1/2

11. Static water level: _____ mo./day/yr.
124 ft. below land surface Date 3-13-76

12. Pumping level below land surfaces:
185 ft. after 4 hrs. pumping 1250 g.p.m.
190 ft. after 4 hrs. pumping 1300 g.p.m.
Estimated maximum yield 1300 g.p.m.

13. Water sample submitted: _____ mo./day/yr.
Yes No Date _____

14. Well head completion:
Pile adapter _____ Inches above grade
 Well grouted?
With: Neat cement Bentonite Concrete
Depth: From 10 ft. to 15 ft.

16. Nearest source of possible contamination:
ft. 1320 Direction S Type Septic
Well disinfected upon completion? Yes No

17. Pump: Not installed
Manufacturer's name Western Land Roller
Model number _____ HP _____ Volts _____
Length of drop pipe 210 ft. capacity 1300 g.p.m.
Type:
 Submersible Turbine
 Jet Reciprocating
 Centrifugal Other

18. Elevation: _____ 19. Remarks: Shale
BROCK 220'

Topography:
 Hill
 Slope
 Upland
 Valley

20. Water well contractor's certification:
This well was drilled under my jurisdiction and this report is true to the best of my knowledge and belief.
Weishaar Drilling 232
Business name _____ License No. _____
Address Scott City, KS 67871
Signed [Signature] Date 7-19-76
Authorized representative

15 39 21
Sec
1/4 1/4 1/4
NUSUSCO