

USE TYPEWRITER OR BALL POINT PEN-PRESS FIRMLY, PRINT CLEARLY.

WATER WELL RECORD
KSA 82a-1201-1215


Kansas Department of Health and Environment-Division of Environment
(Water well Contractors)
Topeka, Kansas 66620

M.A.A.

1. Location of well: County **Wallace** Fraction **N/E 1/4 N/E 1/4 S/E 1/4** Section number **26** Township number **T 15 S R 39** Range number **#W**

2. Distance and direction from nearest town or city:
9¹/₂ N., 15 N., 3¹/₂ W., 1 N., 1¹/₂ W. of Leoti
Street address of well location if in city:

3. Owner of well: **Floyd Larson**
R.R. or street:
City, state, zip code: **Sha ron Springs, KS 67758**

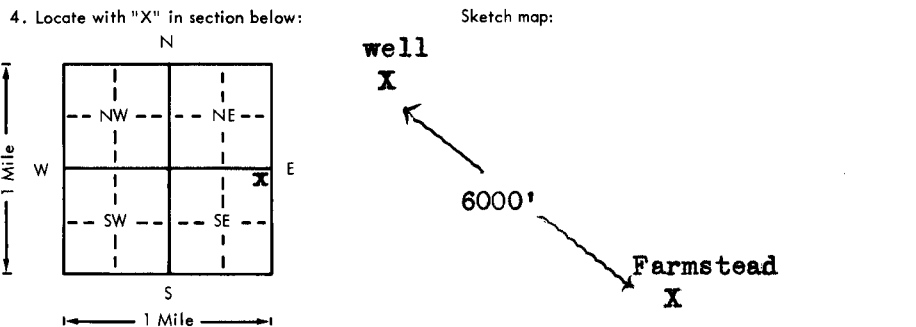

6. Bore hole dia. **26** in. Completion date _____
Well depth **238** ft. **12-22-1978**

7. Cable tool Rotary Driven Dug
 Hollow rod Jetted Bored Reverse rotary

8. Use: Domestic Public supply Industry
 Irrigation Air conditioning Stock
 Lawn Oil field water Other

9. Casing: Material **Steel** Height: Above or below
Threaded _____ Welded Surface **10** in.
RMP _____ PVC _____ Weight **31.67** lbs./ft.
Dia. **16** in. to **198** ft. depth Wall Thickness: inches or
Dia. _____ in. to _____ ft. depth Gauge No. **188**

5. Type and color of material	From	To
clay	0	30
gyp	30	48
rock H	48	51
gyp	51	56
clay	56	60
sand coarse	60	71
clay	71	80
sand coarse	80	91
clay	91	98
sand coarse	98	110
clay	110	127
fine sand clay	127	138
sand coarse	138	155
clay	155	161
fine sand clay	161	197
sand coarse	197	235
yellow	235	238
shale	238	240
(Use a second sheet if needed)		

10. Screen: Manufacturer's name _____
Free Flow
Type **steel** Dia. **16"**
Slot/gauze **.125** Length **40'**
Set between **198** ft. and **238** ft.
_____ ft. and _____ ft.
Gravel pack? **yes** Size range of material **5/8" down**

11. Static water level: _____ mo./day/yr.
138 ft. below land surface Date **10-18-78**

12. Pumping level below land surfaces:
205 ft. after **4** hrs. pumping **660** g.p.m.
220 ft. after **4** hrs. pumping **800** g.p.m.
Estimated maximum yield **800** g.p.m.

13. Water sample submitted: _____ mo./day/yr.
Yes No Date _____

14. Well head completion:
 Pitless adapter **10** Inches above grade

15. Well grouted? **yes**
With: Neat cement Bentonite Concrete
Depth: From **0** ft. to **10** ft.

16. Nearest source of possible contamination:
ft. **6000** Direction **S/E** Type **Farmstead**
Well disinfected upon completion? **yes** Yes No

17. Pump: _____ Not installed
Manufacturer's name **Western Land Roller**
Model number _____ HP _____ Volts _____
Length of drop pipe **220** ft. capacity **800** g.p.m.
Type:
 Submersible Turbine
 Jet Reciprocating
 Centrifugal Other

18. Elevation:

Topography:
 Hill
 Slope
 Upland
 Valley

19. Remarks:

BROCK 235'

20. Water well contractor's certification:
This well was drilled under my jurisdiction and this report is true to the best of my knowledge and belief.
Weishaar Drilling & Sup. 232
Business name License No. _____
Address **Scott City, KS 67871**
Signed *[Signature]* Date **1/8/79**
Authorized representative

T
R
W
Sec
1/4 1/4 1/4