

USE TYPEWRITER OR BALL POINT PEN—PRESS FIRMLY, PRINT CLEARLY.


WATER WELL RECORD  
KSA 82a-1201-1215

Kansas Department of Health and Environment—Division of Environment (Water well Contractors)  
Topeka, Kansas 66620

AAC

1. Location of well: County Wallace Fraction SW 1/4 NE 1/4 NE 1/4 Section number 27 Township number T 15 S R 39 E/W

2. Distance and direction from nearest town or city: 135 2 1/2 W 1/4 S OF WALLACE  
Street address of well location if in city: OF WALLACE  
3. Owner of well: Don Pletcher  
R.R. or street: \_\_\_\_\_  
City, state, zip code: Sharon Springs Kansas 67758

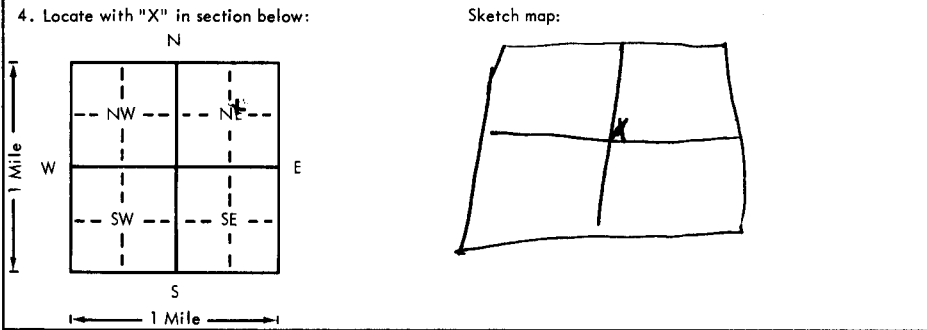

6. Bore hole dia. 24 in. Completion date 1-25-79  
Well depth 206 ft.  
7. Cable tool \_\_\_ Rotary \_\_\_ Driven \_\_\_ Dug \_\_\_ Hollow rod \_\_\_ Jetted \_\_\_ Bored  Reverse rotary  
8. Use: Domestic \_\_\_ Public supply \_\_\_ Industry  Irrigation \_\_\_ Air conditioning \_\_\_ Stock \_\_\_ Lawn \_\_\_ Oil field water \_\_\_ Other

5. Type and color of material	From	To
<u>Top Soil</u>	<u>0</u>	<u>3</u>
<u>Clay Sandstone &amp; Gravel</u>	<u>3</u>	<u>100</u>
<u>Gravel</u>	<u>100</u>	<u>115</u>
<u>Sandstone &amp; Sandyclay</u>	<u>115</u>	<u>144</u>
<u>Sand</u>	<u>144</u>	<u>148</u>
<u>Sandyclay</u>	<u>148</u>	<u>155</u>
<u>Gravel</u>	<u>155</u>	<u>197</u>
<u>Soapstone</u>	<u>197</u>	<u>205</u>
<u>Shale</u>	<u>205</u>	<u>206</u>
<u>BROCK 197'</u>		

9. Casing: Material Steel Height: Above or below  
Threaded \_\_\_ Welded  Surface 12 in.  
RMP \_\_\_ PVC \_\_\_ Weight 32 lb./ft.  
Dia. 16 in. to 132 ft. depth Wall Thickness: inches or  
Dia. \_\_\_ in. to \_\_\_ ft. depth gage No. 188

10. Screen: Manufacturer's name W.A. BRAUN  
Type Key Punch Dia. 16"  
Slot gauze 48 Length 100'  
Set between 132 ft. and 232 ft.  
Gravel pack?  Size range of material 48

11. Static water level: mo./day/yr. 121 ft. below land surface Date 1-25-79

12. Pumping level below land surfaces:  
200 ft. after 8 hrs. pumping 1050 g.p.m.  
\_\_\_ ft. after \_\_\_ hrs. pumping \_\_\_ g.p.m.  
Estimated maximum yield 1050 g.p.m.

13. Water sample submitted: mo./day/yr. Yes  No \_\_\_ Date \_\_\_

14. Well head completion: IRONC  
\_\_\_ Pitless adapter \_\_\_ laches above grade

15. Well grouted?   
With:  Neat cement \_\_\_ Bentonite \_\_\_ Concrete  
Depth: From 132 to 11 ft.

16. Nearest source of possible contamination: ft. \_\_\_ Direction \_\_\_ Type \_\_\_  
Well disinfected upon completion? \_\_\_ Yes \_\_\_ No

17. Pump: Not installed  
Manufacturer's name JOHNSTON  
Model number HA-100 HP \_\_\_ Volts \_\_\_  
Length of drop pipe 230 ft. capacity 70 g.p.m.  
Type: \_\_\_ Submersible  Turbine \_\_\_ Jet \_\_\_ Reciprocating \_\_\_ Centrifugal \_\_\_ Other \_\_\_

18. Elevation: \_\_\_\_\_  
19. Remarks: Concrete was Run By. Frost Supply Co. Inc.  
Topography:  Hill \_\_\_ Slope \_\_\_ Upland \_\_\_ Valley

20. Water well contractor's certification:  
This well was drilled under my jurisdiction and this report is true to the best of my knowledge and belief.  
Frost Supply Co. Inc. 144  
Business name License No.  
Address Box 938 Andover, Kans.  
Signed [Signature] Date 2-28-79  
Authorized representative

T 15 S 39 R 27 SW NE 1/4