

USE TYPEWRITER OR BALL POINT PEN-PRESS FIRMLY, PRINT CLEARLY.


WATER WELL RECORD
KSA 82a-1201-1215

Kansas Department of Health and Environment-Division of Environment
(Water well Contractors)
Topeka, Kansas 66620

DAA

1. Location of well: County **Wallace** Fraction **NE 1/4 NE 1/4 SE 1/4** Section number **28** Township number T **15** S R **39** E **W**

2. Distance and direction from nearest town or city: **1 1/2 N, 3 1/2 W, 2 N,**
Street address of well location if in city: **3 1/2 W, 1/2 S, 1/2 E of Selkirk, KS**
3. Owner of well: **Jack Larson**
R.R. or street: **RFD #1 - Box 17**
City, state, zip code: **Sharon Springs, KS 67758**

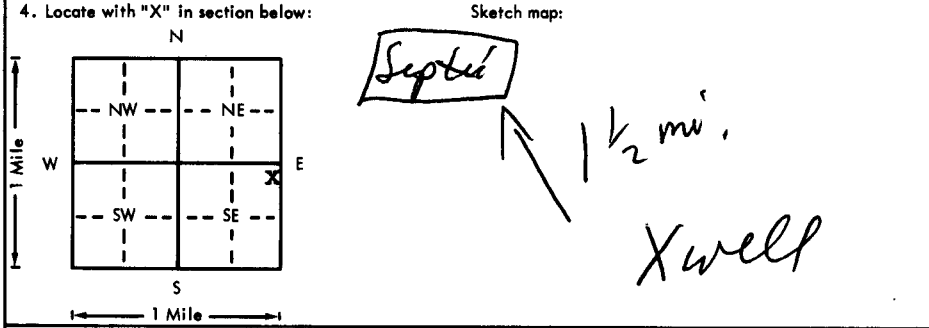

6. Bore hole dia. **26** in. Completion date _____
Well depth **193** ft. **5-28-76**

7. Cable tool ___ Rotary ___ Driven ___ Dug ___
Hollow rod ___ Jetted ___ Bored Reverse rotary

8. Use: Domestic ___ Public supply ___ Industry ___
 Irrigation ___ Air conditioning ___ Stock ___
Lawn ___ Oil field water ___ Other ___

9. Casing: Material **steel** Height **above** below
Threaded ___ Welded Surface **10** in.
RMP ___ PVC ___ Weight **31.67** lbs./ft.
Dia. **16** in. to **193** ft. depth Wall Thickness: inches or
Dia. ___ in. to ___ ft. depth gage No. **.188**

5. Type and color of material	From	To
Clay	0	28
Fine sd clay	28	36
Sd coarse	36	42
Fine sd clay	42	115
Sd coarse	115	127
Sd rock	127	129
Fine sd clay	129	137
Sd coarse	137	143
Fine sd clay	143	151
Sd coarse	151	157
Clay	157	161
Sd coarse	161	170
Sd rock	170	173
Sd coarse	173	191
Clay	191	195
Shale	195	200

10. Screen: Manufacturer's name _____
Free Flow

Type **Prime Steel** Dia. **16 in.**
Gauge **.125** Length **40 ft.**
Set between **153** ft. and **193** ft.
ft. and _____ ft.
Gravel pack? **yes** Size range of material **3/4-1/2**

11. Static water level: _____ mo./day/yr.
108 ft. below land surface Date **5-9-76**

12. Pumping level below land surfaces:
155 ft. after **4** hrs. pumping **750** g.p.m.
160 ft. after **4** hrs. pumping **800** g.p.m.
Estimated maximum yield **800** g.p.m.

13. Water sample submitted: _____ mo./day/yr.
Yes: No _____ Date _____

14. Well head completion: _____ inches above grade
 Well grouted?
With: ___ Neat cement ___ Bentonite Concrete
Depth: From **2** ft. to **15** ft.

16. Nearest source of possible contamination:
ft. **7920** Direction **NW** Type **Septic**
Well disinfected upon completion? Yes ___ No

17. Pump: _____ Not installed
Manufacturer's name **Simmons**
Model number _____ HP _____ Volts _____
Length of drop pipe **180** ft. capacity **800** g.p.m.
Type: ___ Submersible ___ Turbine
___ Jet ___ Reciprocating
___ Centrifugal ___ Other

18. Elevation: _____
19. Remarks: **BROCK 195'**

Topography: ___ Hill
 Slope ___ Upland ___ Valley

20. Water well contractor's certification:
This well was drilled under my jurisdiction and this report is true to the best of my knowledge and belief.
Weishaar Drilling **232**
Business name _____ License No. _____
Address **Scott City, KS 67871**
Signature _____ Date **7-21-76**
Authorized representative

15 39 E 28 NE NESE