


1 LOCATION OF WATER WELL: County: Wallace Fraction: NE 1/4 NW 1/4 NE 1/4 Section Number: 29 Township Number: T 15 S Range Number: R 39 E

Distance and direction from nearest town or city street address of well if located within city?
17 m SW of Wallace

2 WATER WELL OWNER: Randy & Celia Roudale
 RR#, St. Address, Box #: Wallace Kansas 67761
 City, State, ZIP Code: Wallace Kansas 67761
 Board of Agriculture, Division of Water Resources
 Application Number:

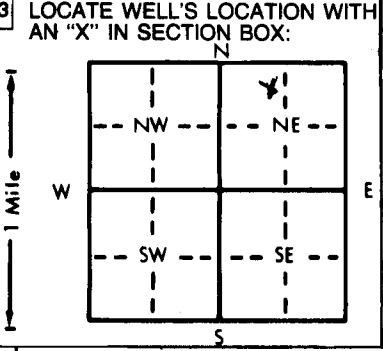

4 DEPTH OF COMPLETED WELL: 200 ft. ELEVATION: ft.
 Depth(s) Groundwater Encountered 1. ft. 2. ft. 3. ft.
 WELL'S STATIC WATER LEVEL 9.7 ft. below land surface measured on mo/day/yr 11-30-80
 Pump test data: Well water was ft. after hours pumping gpm
 Est. Yield gpm: Well water was not tested after hours pumping gpm
 Bore Hole Diameter: 8 in. to 200 ft., and in. to ft.
 WELL WATER TO BE USED AS:
 1 Domestic 3 Feedlot 6 Oil field water supply 9 Dewatering 11 Injection well
 2 Irrigation 4 Industrial 7 Lawn and garden only 10 Observation well
 Was a chemical/bacteriological sample submitted to Department? Yes.....No..... No; If yes, mo/day/yr sample was submitted
 Water Well Disinfected? Yes No

5 TYPE OF BLANK CASING USED:
 1 Steel 2 RMP (SR) 3 Wrought iron 4 Concrete tile CASING JOINTS: Glued Clamped
 2 PVC 4 ABS 5 Asbestos-Cement 6 Other (specify below) Welded
 3 Fiberglass Threaded
 Blank casing diameter 5 in. to 180 ft., Dia. in. to ft., Dia. in. to ft.
 Casing height above land surface 18 in., weight 18/10 lbs./ft. Wall thickness or gauge No. 1/4"
 TYPE OF SCREEN OR PERFORATION MATERIAL:
 1 Steel 3 Stainless steel 5 Fiberglass 6 RMP (SR) 7 PVC 10 Asbestos-cement
 2 Brass 4 Galvanized steel 6 Concrete tile 9 ABS 11 Other (specify)
 12 None used (open hole)
 SCREEN OR PERFORATION OPENINGS ARE:
 1 Continuous slot 3 Mill slot 5 Gauzed wrapped 6 Saw cut 11 None (open hole)
 2 Louvered shutter 4 Key punched 6 Wire wrapped 9 Drilled holes
 7 Torch cut 10 Other (specify)
 SCREEN-PERFORATED INTERVALS: From 180 ft. to 200 ft., From ft. to ft.
 From ft. to ft., From ft. to ft.
 GRAVEL PACK INTERVALS: From 18 ft. to 200 ft., From ft. to ft.
 From ft. to ft., From ft. to ft.

6 GROUT MATERIAL: 1 Neat cement 2 Cement grout 3 Bentonite 4 Other
 Grout Intervals: From 4 ft. to 18 ft., From ft. to ft., From ft. to ft.
 What is the nearest source of possible contamination:
 1 Septic tank 4 Lateral lines 7 Pit privy 10 Livestock pens 14 Abandoned water well
 2 Sewer lines 5 Cess pool 8 Sewage lagoon 11 Fuel storage 15 Oil well/Gas well
 3 Watertight sewer lines 6 Seepage pit 9 Feedyard 12 Fertilizer storage 16 Other (specify below)
 13 Insecticide storage PASTURE
 Direction from well? How many feet?

| FROM | TO | LITHOLOGIC LOG | FROM | TO | LITHOLOGIC LOG |
|------|-----|-------------------------|------|----|---|
| 1 | 14 | Topsoil | | | |
| 14 | 40 | fine Sand | | | |
| 40 | 71 | Sand - Strips of Clay | | | When we drilled this well in 80 we were to finish it when they were ready. Recently we found out they had finished it up them selves. |
| 71 | 92 | Sand - Sand Rock Strips | | | |
| 92 | 110 | Sand (neg) | | | |
| 110 | 120 | Sand - Sand Rock | | | |
| 120 | 124 | Sand Rock | | | |
| 124 | 126 | SOAP Stone | | | |
| 126 | 150 | Sand - Sand rock Strips | | | |
| 150 | 154 | Sand Rock | | | |
| 154 | 170 | Sand - Sand Rock Strips | | | |
| 170 | 197 | Gravel Good | | | |
| 197 | 200 | Shale | | | |

7 CONTRACTOR'S OR LANDOWNER'S CERTIFICATION: This water well was (1) constructed, (2) reconstructed, or (3) plugged under my jurisdiction and was completed on (mo/day/year) 11-30-80 and this record is true to the best of my knowledge and belief. Kansas Water Well Contractor's License No. 131 This Water Well Record was completed on (mo/day/yr) 6-7-82 under the business name of Bartell Drilling by (signature) Joyce Bartell

INSTRUCTIONS: Use typewriter or ball point pen, PLEASE PRESS FIRMLY and PRINT clearly. Please fill in blanks under line or circle the correct answers. Send top three copies to Kansas Department of Health and Environment, Division of Environment, Environmental Geology Section, Topeka, KS 66620. Send one to WATER WELL OWNER and retain one for your records.

OFFICE USE ONLY
T
15 R 39
SEC. 29
NE 1/4 NW 1/4 SE 1/4