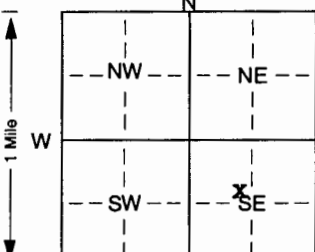


1 LOCATION OF WATER WELL:		Fraction	Section Number	Township Number	Range Number
County: SALINE		SE 1/4 NW 1/4 SE 1/4	1	T 15 S	R 4 W EW
Distance and direction from nearest town or city street address of well if located within city? WELL #3					
NORTHWEST OF INTERSECTION WATERWELL RD. & LIGHTVILLE RD. TRACT #16 SOUTHEAST CORNER(SOUTH ONE)					
2 WATER WELL OWNER: L.E. FINK			SALINE COUNTY PERMIT #00-204		
RR#, St. Address, Box # : 2065 WESLEY			Board of Agriculture, Division of Water Resources		
City, State, ZIP Code : SALINA, KS. 67401			Application Number:		
3 LOCATE WELL'S LOCATION WITH		4 DEPTH OF COMPLETED WELL: 35 ft. ELEVATION:			
AN "X" IN SECTION BOX:		Depth(s) Groundwater Encountered 10 ft. 2. ft. 3. ft. 4-19-00 ft.			
		WELL'S STATIC WATER LEVEL 10 ft. below land surface measured on mo/day/yr			
		Pump test data: Well water was 18.5 ft. after 2 hours pumping 15 gpm			
		Est. Yield 25 gpm: Well water was ft. after hours pumping gpm			
		Bore Hole Diameter 9 in. to 35 ft., and in. to ft.			
		WELL WATER TO BE USED AS: 5 Public water supply 8 Air conditioning 11 Injection well			
		1 Domestic 3 Feedlot 6 Oil field water supply 9 Dewatering 12 Other (Specify below)			
		2 Irrigation 4 Industrial 7 Domestic (lawn & garden) 10 Monitoring well			
		Was a chemical/bacteriological sample submitted to Department? Yes. No. X; If yes, mo/day/yr sample was submitted			
		Water Well Disinfected? Yes X No			
5 TYPE OF BLANK CASING USED:					
1 Steel 3 RMP (SR) 5 Wrought iron 8 Concrete tile CASING JOINTS: Glued. X Clamped.					
2 PVC 4 ABS 6 Asbestos-Cement 9 Other (specify below) Welded					
7 Fiberglass Threaded					
Blank casing diameter 5 in. to 25 ft., Dia 160 in. to ft., Dia in. to SDR 26					
Casing height above land surface 20 in., weight lbs./ft. Wall thickness or gauge No.					
TYPE OF SCREEN OR PERFORATION MATERIAL:					
1 Steel 3 Stainless steel 5 Fiberglass 7 PVC 10 Asbestos-cement					
2 Brass 4 Galvanized steel 6 Concrete tile 8 RMP (SR) 11 Other (specify)					
9 ABS 12 None used (open hole)					
SCREEN OR PERFORATION OPENINGS ARE:					
1 Continuous slot 3 Mill slot .025 5 Gauzed wrapped 8 Saw cut 11 None (open hole)					
2 Louvered shutter 4 Key punched 6 Wire wrapped 9 Drilled holes					
7 Torch cut 10 Other (specify) ft.					
SCREEN-PERFORATED INTERVALS: From 25 ft. to 35 ft., From ft. to ft.					
From ft. to ft., From ft. to ft.					
GRAVEL PACK INTERVALS: From 22 ft. to 35 ft., From ft. to ft.					
From ft. to ft., From ft. to ft.					
6 GROUT MATERIAL: 1 Neat cement 2 Cement grout 3 Bentonite 4 Other					
Grout Intervals: From 0 ft. to 22 ft., From ft. to ft., From ft. to ft.					
What is the nearest source of possible contamination:					
1 Septic tank 4 Lateral lines 7 Pit privy 10 Livestock pens 14 Abandoned water well					
2 Sewer lines 5 Cess pool 8 Sewage lagoon 11 Fuel storage 15 Oil well/Gas well					
3 Watertight sewer lines 6 Seepage pit 9 Feedyard 12 Fertilizer storage 16 Other (specify below)					
13 Insecticide storage					
Direction from well? How many feet? OPEN FIELD NONE APPARENT					
FROM	TO	LITHOLOGIC LOG	FROM	TO	PLUGGING INTERVALS
0	2	TOP SOIL			
2	7	CLAY REDDISH BROWN			
7	22	SANDSTONE RED			GROUT WAIVER OKed BY
22	35	SANDSTONE TAN			RICHARD HARPER PER PHONE CALL
35		SHALE GRAY			4-13-00
7 CONTRACTOR'S OR LANDOWNER'S CERTIFICATION: This water well was (1) constructed, (2) reconstructed, or (3) plugged under my jurisdiction and was completed on (mo/day/year) 4-19-00 and this record is true to the best of my knowledge and belief. Kansas Water Well Contractor's Licence No. 388 This Water Well Record was completed on (mo/day/yr) 4-25-00 under the business name of PESTINGER PUMP SERVICE by (signature)					
INSTRUCTIONS: Use typewriter or ball point pen. PLEASE PRESS FIRMLY and PRINT clearly. Please fill in blanks, underline or circle the correct answers. Send top three copies to Kansas Department of Health and Environment, Bureau of Water, Topeka, Kansas 66620-0001. Telephone 785-296-5524. Send one to WATER WELL OWNER and retain one for your records. Fee of \$5.00 for each constructed well.					