


Correction

WATER WELL PLUGGING RECORD Form WWC-5P KSA 82a-1212 ID NO. MW-5 55020

1 LOCATION OF WATER WELL: County: Saline Fraction SE 1/4 NW 1/4 NE 1/4 NW 1/4 Section Number 17 Township Number T 15 S Range Number 4

Street/Rural Address of Well Location; if unknown, distance & direction from nearest town or intersection: If at owner's address, check here [] Global Positioning Systems (GPS) information: Latitude: 38.753018 Longitude: -97.792956 Elevation: NA

2 WATER WELL OWNER: Smoky Hill Ang Range RR#, St. Address, Box #: 6429 W Farrelly Road City, State ZIP Code: Salina, Ks. 67401

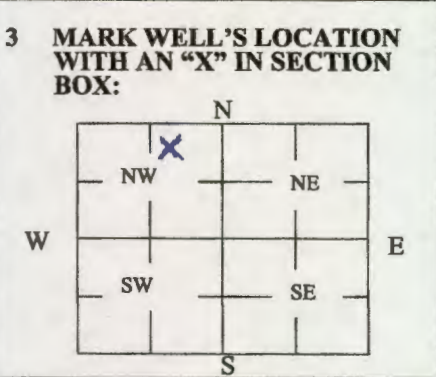

3 MARK WELL'S LOCATION WITH AN 'X' IN SECTION BOX: 4 DEPTH OF WELL 11.9 ft. WELL'S STATIC WATER LEVEL 7.44 ft. WELL WAS USED AS: [] Domestic [] Irrigation [] Feedlot [] Industrial [] Public Water Supply [] Oil Field Water Supply [] Domestic (Lawn & Garden) [] Air Conditioning [] Dewatering [] Monitoring [] Injection Well [] Other

5 TYPE OF BLANK CASING USED: [] Steel [] RMP (SR) [] Wrought [] Fiberglass [] Other (Specify below) [] PVC [] ABS [] Asbestos-Cement [] Concrete Tile

6 GROUT PLUG MATERIAL: [] Neat cement [] Cement grout [] Bentonite [] Other site soils Grout Plug Intervals: From 0.3 ft. to 11.9 ft., From 0 ft. to 0.3 ft., From ___ ft. to ___ ft.

Table with 6 columns: FROM, TO, PLUGGING MATERIALS, FROM, TO, PLUGGING MATERIALS. Row 1: 0, 11.9, Bentonite, empty, empty, empty.

7 CONTRACTOR'S OR LANDOWNER'S CERTIFICATION: This water well was plugged under my jurisdiction and was completed on (mo/day/year) 2/10/2022 and this record is true to the best of my knowledge and belief.