

Correction


MW-05 DP009

WATER WELL PLUGGING RECORD Form WWC-5P KSA 82a-1212 ID NO.

1 LOCATION OF WATER WELL: County: Saline Fraction NE 1/4 SE 1/4 NW 1/4 NW 1/4 Section Number 17 Township Number T 15 S Range Number 4 E W

Street/Rural Address of Well Location; if unknown, distance & direction from nearest town or intersection: If at owner's address, check here [] Global Positioning Systems (GPS) information: Latitude: 38.752455 (in decimal degrees) Longitude: -97.795499 (in decimal degrees) Elevation: NA Horizontal Datum: [x] WGS84, [] NAD83, [] NAD27 Collection Method: [x] GPS unit (Make/Model: [] Digital Map/Photo, [] Topographic Map, [] Land Survey Est. Accuracy: [] < 3 m, [] 3-5 m, [] 5-15 m, [] > 15 m

2 WATER WELL OWNER: Smoky Hill Ang Range RR#, St. Address, Box #: 6429 W Farrelly Road City, State ZIP Code: Salina, Ks. 67401

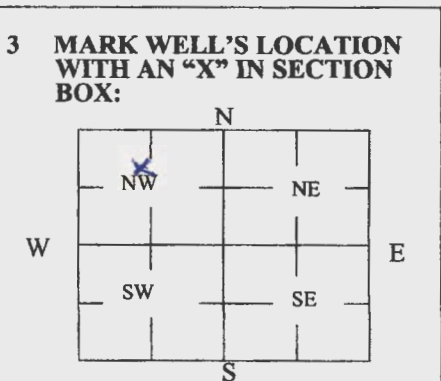

3 MARK WELL'S LOCATION WITH AN "X" IN SECTION BOX: 4 DEPTH OF WELL 21.7 ft. WELL'S STATIC WATER LEVEL 8.2 ft. WELL WAS USED AS: [] Domestic [] Irrigation [] Feedlot [] Industrial [] Public Water Supply [] Oil Field Water Supply [] Domestic (Lawn & Garden) [] Air Conditioning [] Dewatering [x] Monitoring [] Injection Well [] Other Was a chemical/bacteriological sample submitted to Department? Yes [] No [x]

5 TYPE OF BLANK CASING USED: [] Steel [x] PVC [] RMP (SR) [] ABS [] Wrought [] Asbestos-Cement [] Fiberglass [] Concrete Tile [] Other (Specify below) Blank casing diameter 2 in. Was casing pulled? Yes [x] No [] If yes, how much 5 ft. 3 ft. Casing height above or below land surface 0 in.

6 GROUT PLUG MATERIAL: [] Neat cement [] Cement grout [x] Bentonite [x] Other Site Soils Grout Plug Intervals: From 0.3 ft. to 21.7 ft., From 0 ft. to 0.3 ft., From ___ ft. to ___ ft. What is the nearest source of possible contamination: [] Septic tank [] Sewer lines [] Watertight sewer lines [] Lateral lines [] Cess pool [] Seepage pit [] Pit privy [] Sewage lagoon [] Feedyard [] Livestock pens [] Fuel storage [] Fertilizer storage [] Insecticide storage [] Abandoned water well [] Oil well/Gas well [x] Other (specify below) Air National Guard Range Direction from well? How many feet? contaminated site

FROM	TO	PLUGGING MATERIALS	FROM	TO	PLUGGING MATERIALS
0	21.7	Bentonite			

7 CONTRACTOR'S OR LANDOWNER'S CERTIFICATION: This water well was plugged under my jurisdiction and was completed on (mo/day/year) 2/10/2022 and this record is true to the best of my knowledge and belief. Kansas Water Well Contractor's License No. 604. This Water Well Record was completed on (mo/day/year) 3/7/22 under the business name of Environmental Priority Service, Inc. by (signature) PTA [Signature]

Send one white copy to Kansas Department of Health & Environment, Geology Section, 1000 SW Jackson Street, Ste. 420, Topeka, KS 66612-1367. Send one copy to WATER WELL OWNER and retain one for your records. Visit us at http://www.kdheks.gov/waterwell/index.html Telephone 785-296-5524.