


Correction

1 LOCATION OF WATER WELL: Fraction NE 1/4 SE 1/4 NW 1/4 NW 1/4 Section Number 17 Township Number T 15 S Range Number 4 E W

Street/Rural Address of Well Location; if unknown, distance & direction from nearest town or intersection: If at owner's address, check here [ ] Global Positioning Systems (GPS) information: Latitude: 38.752085 (in decimal degrees) Longitude: -97.795758 (in decimal degrees) Elevation: NA Horizontal Datum: [x] WGS84, [ ] NAD83, [ ] NAD27 Collection Method: [x] GPS unit (Make/Model: [ ] Digital Map/Photo, [ ] Topographic Map, [ ] Land Survey Est. Accuracy: [ ] < 3 m, [ ] 3-5 m, [ ] 5-15 m, [ ] > 15 m

2 WATER WELL OWNER: Smoky Hill Ang Range RR#, St. Address, Box #: 6429 W Farrelly Road City, State ZIP Code: Salina, Ks. 67401

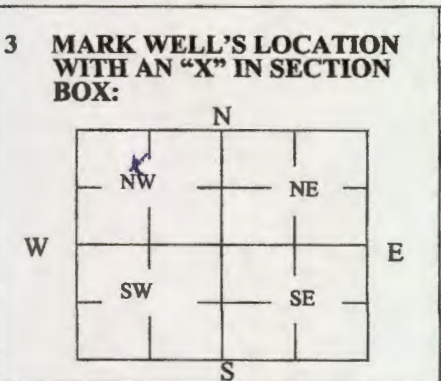

4 DEPTH OF WELL 20.9 ft. WELL'S STATIC WATER LEVEL 10.7 ft. WELL WAS USED AS: [ ] Domestic [ ] Irrigation [ ] Feedlot [ ] Industrial [ ] Public Water Supply [ ] Oil Field Water Supply [ ] Domestic (Lawn & Garden) [ ] Air Conditioning [ ] Dewatering [x] Monitoring [ ] Injection Well [ ] Other [ ] Was a chemical/bacteriological sample submitted to Department? Yes [ ] No [x]

5 TYPE OF BLANK CASING USED: [ ] Steel [x] PVC [ ] RMP (SR) [ ] ABS [ ] Wrought [ ] Asbestos-Cement [ ] Fiberglass [ ] Concrete Tile [ ] Other (Specify below) Blank casing diameter 2 in. Was casing pulled? Yes [x] No [ ] If yes, how much 5 ft - 3 ft. Casing height above or below land surface 0 in.

6 GROUT PLUG MATERIAL: [ ] Neat cement [ ] Cement grout [x] Bentonite [x] Other site soils Grout Plug Intervals: From 0.3 ft. to 20.9 ft., From 0 ft. to 0.3 ft., From \_\_\_ ft. to \_\_\_ ft. What is the nearest source of possible contamination: [ ] Septic tank [ ] Sewer lines [ ] Watertight sewer lines [ ] Lateral lines [ ] Cess pool [ ] Seepage pit [ ] Pit privy [ ] Sewage lagoon [ ] Feedyard [ ] Livestock pens [ ] Fuel storage [ ] Fertilizer storage [ ] Insecticide storage [ ] Abandoned water well [ ] Oil well/Gas well [x] Other (specify below) Air National Guard Range Direction from well? How many feet? contaminated site

Table with columns: FROM, TO, PLUGGING MATERIALS. Row 1: 0, 20.9, Bentonite.

7 CONTRACTOR'S OR LANDOWNER'S CERTIFICATION: This water well was plugged under my jurisdiction and was completed on (mo/day/year) 2/10/2022 and this record is true to the best of my knowledge and belief. Kansas Water Well Contractor's License No. 604 This Water Well Record was completed on (mo/day/year) 3/7/22 under the business name of Environmental Priority Service, Inc. by (signature) P. H. [Signature]

Send one white copy to Kansas Department of Health & Environment, Geology Section, 1000 SW Jackson Street, Ste. 420, Topeka, KS 66612-1367. Send one copy to WATER WELL OWNER and retain one for your records. Visit us at http://www.kdheks.gov/waterwell/index.html Telephone 785-296-5524.