Well No. SLF1 MW1

WATER WELL RECORD Form WWC-5 KSA 82a-1212

1 LOCATION OF WATER WELL: County: Sedgwick | Fraction: SE ¼ NW ¼ NW ¼ | Section Number: 17 | Township Number: T 15 S | Range Number: R 4 W

Distance and direction from nearest town or city street address of well if located within city?

2 WATER WELL OWNER: McConnell AFB (Smoky Hill Weapons-Range)

RR#, St. Address, Box # :

City, State, ZIP Code : Wichita, Kansas

Board of Agriculture, Division of Water Reso

Application Number:

3 LOCATE WELL'S LOCATION WITH AN "X" IN SECTION BOX:

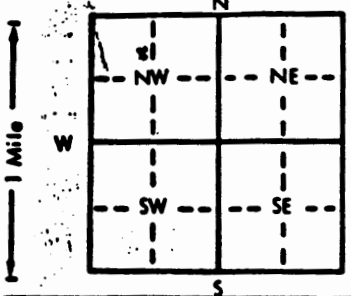

4 DEPTH OF COMPLETED WELL 24.6 ft. ELEVATION:

Depth(s) Groundwater Encountered 1. 17.0 ft. 2. ft. 3.

WELL'S STATIC WATER LEVEL 16.25 ft. below land surface measured on mo/day/yr 11/17/88

Pump test data: Well water was ft. after hours pumping g

Est. Yield gpm: Well water was ft. after hours pumping g

Bore Hole Diameter 11 in. to 24.6 ft., and in. to

WELL WATER TO BE USED AS: 5 Public water supply 8 Air conditioning 11 Injection well
1 Domestic 3 Feedlot 6 Oil field water supply 9 Dewatering 12 Other (Specify below)
2 Irrigation 4 Industrial 7 Lawn and garden only 10 Monitoring well

Was a chemical/bacteriological sample submitted to Department? Yes No X ; If yes, mo/day/yr sample was mitted

Water Well Disinfected? Yes No

5 TYPE OF BLANK CASING USED: 5 Wrought iron 8 Concrete tile CASING JOINTS: Glued Clamped
1 Steel 3 RMP (SR) 6 Asbestos-Cement 9 Other (specify below) Welded
(2 PVC) 4 ABS 7 Fiberglass Threaded

Blank casing diameter 2 in. to 11.1 ft., Dia in. to ft., Dia in. to

Casing height above land surface 1.5 in., weight lbs./ft. Wall thickness or gauge No. Sch 40

TYPE OF SCREEN OR PERFORATION MATERIAL: (7 PVC)
1 Steel 3 Stainless steel 5 Fiberglass 8 RMP (SR) 10 Asbestos-cement
2 Brass 4 Galvanized steel 6 Concrete tile 9 ABS 11 Other (specify)
12 None used (open hole)

SCREEN OR PERFORATION OPENINGS ARE: 5 Gauzed wrapped 8 Saw cut 11 None (open hole)
1 Continuous slot (3 Mill slot) 6 Wire wrapped 9 Drilled holes
2 Louvered shutter 4 Key punched 7 Torch cut 10 Other (specify)

SCREEN-PERFORATED INTERVALS: From 11.1 ft. to 21.1 ft., From ft. to
From ft. to ft., From ft. to

GRAVEL PACK INTERVALS: From 6.8 ft. to 24.6 ft., From ft. to
From ft. to ft., From ft. to

6 GROUT MATERIAL: 1 Neat cement 2 Cement grout (3 Bentonite) 4 Other Cement / Bentonite Grout

Grout Intervals: From 2.0 ft. to 4.4 ft., From 4.4 ft. to 6.8 ft., From ft. to

What is the nearest source of possible contamination:
10 Livestock pens 14 Abandoned water well
1 Septic tank 4 Lateral lines 7 Pit privy 11 Fuel storage 15 Oil well/Gas well
2 Sewer lines 5 Cess pool 8 Sewage lagoon 12 Fertilizer storage (16) Other (specify below)
3 Watertight sewer lines 6 Seepage pit 9 Feedyard 13 Insecticide storage Landfill

Direction from well? How many feet?

FROM	TO	LITHOLOGIC LOG
0	1.0	Silt – Br Ja Dry
1.0	3.0	Sand – Lt Br " Dry
3.0	13.0	Sand – Tan "
13.0	16.0	" – Br Damp
16.0	24.6	Shale – Gr

FROM	TO	PLUGGING INTERVALS

RECEIVED
JUN 15 1989
DIVISION OF ENVIRONMENT

RECEIVED
OCT 27 1989
DIVISION OF ENVIRONMENT

7 CONTRACTOR'S OR LANDOWNER'S CERTIFICATION: This water well was (1) constructed, (2) reconstructed, or (3) plugged under my jurisdiction and wa ompleted on (mo/day/year) 10/1/88 and this record is true to the best of my knowledge and belief. Kansa Vater Well Contractor's License No. 494 This Water Well Record was completed on (mo/day/yr) 11/20/89 nder the business name of Southwestern Lab Inc by (signature) Robert S Smith

INSTRUCTIONS: Use typewriter or ball point pen. *PLEASE PRESS FIRMLY* and *PRINT* clearly. Please fill in blanks, underline or circle the correct answers. Send top three copies to Kansas Department of Health and Environment, Bureau of Water Protection, Topeka, Kansas 66620-7320. Telephone: 913-296-5514. Send one to WATER WELL OWNER and retain one for your records.