

1 LOCATION OF WATER WELL:


1 LOCATION OF WATER WELL:	Fraction	Section Number	Township Number	Range Number

Distance and direction from nearest town or city street address of well if located within city?

2 WATER WELL OWNER: McConnell AFB (Smoky Hill Weapons-Range)

RR#, St. Address, Box # :
City, State, ZIP Code : Wichita, KANSAS

3] LOCATE WELL'S LOCATION WITH AN "X" IN SECTION BOX:

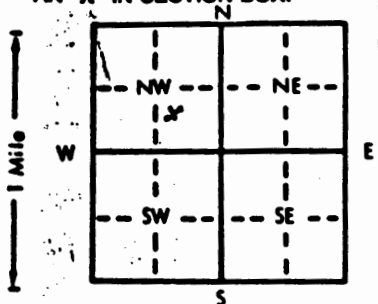

3) LOCATE WELL'S LOCATION WITH 4) DEPTH OF COMPLETED WELL... 34.0... ft. ELEVATION:

AN "X" IN SECTION BOX:

1 Mile

W

E

N

NW	NE
SW	SE

S

Depth(s) Groundwater Encountered 1. 28.0 ft. 2. _____ ft. 3. _____ ft.

WELL'S STATIC WATER LEVEL 24.0 ft. below land surface measured on mo/day/yr 9/12/88

Pump test data: Well water was _____ ft. after _____ hours pumping

Est. Yield _____ gpm: Well water was _____ ft. after _____ hours pumping

Bore Hole Diameter 1.1 in. to 34.0 ft., and _____ in. to _____

WELL WATER TO BE USED AS:

1 Domestic	3 Feedlot	5 Public water supply	8 Air conditioning	11 Injection well
2 Irrigation	4 Industrial	6 Oil field water supply	9 Dewatering	12 Other (Specify below)
		7 Lawn and garden only	10 Monitoring well	

Was a chemical/bacteriological sample submitted to Department? Yes _____ No X _____; If yes, mo/day/yr sample was submitted _____

Water Well Disinfected? Yes _____ No _____

5 TYPE OF BLANK CASING USED:

1 Steel
(2 PVC)
Blank casing diameter 2 in. to 180 ft. Dia in. to ft. Dia in. to ft. Dia
Casing height above land surface 2.1 in. weight lbs./ft. Wall thickness or gauge No. Sch 40

TYPE OF SCREEN OR PERFORATION MATERIAL:

1 Steel 3 Stainless steel 5 Fiberglass 8 RMP (SR) 11 Other (specify)

2 Brass 4 Galvanized steel 6 Concrete tile 9 ABS 12 None used (open hole)

SCREEN OR PERFORATION OPENINGS ARE:

1 Continuous slot 3 Mill slot 6 Wire wrapped 9 Saw cut 11 Trench (open hole)

2 Louvered shutter 4 Key punched 7 Torch cut 10 Other (specify)

SCREEN-PERFORATED INTERVALS:

GRAVEL PACK INTERVALS:

3 GROUT MATERIAL:

Grout Intervals: From 2.3 ft. to 13.5 ft., From 13.5 ft. to 15.5 ft., From ft. to

What is the nearest source of possible contamination:

1 Septic tank	4 Lateral lines	7 Pit privy	10 Insecticide pens	14 Watercourse water well
2 Sewer lines	5 Cess pool	8 Sewage lagoon	11 Fuel storage	15 Oil well/Gas well
3 Watertight sewer lines	6 Seepage pit	9 Feedyard	12 Fertilizer storage	16 Other (specify below)
			13 Insecticide storage	<i>Fuel spill pens</i>

Direction from well?

[illegible]

CONTRACTOR'S OR LANDOWNER'S CERTIFICATION: This water well was (1) constructed, (2) reconstructed, or (3) plugged under my jurisdiction and was completed on (mo/day/year) 10/14/88 and this record is true to the best of my knowledge and belief. Kansas Water Well Contractor's License No. 494 This Water Well Record was completed on (mo/day/yr) 11/30/89 under the business name of Southwestern Lab Inc by (signature) [Signature]

INSTRUCTIONS: Use typewriter or ball point pen. PLEASE PRESS FIRMLY and PRINT clearly. Please fill in blanks, underline or circle the correct answers. Send top three copies to Kansas Department of Health and Environment, Bureau of Water Protection, Topeka, Kansas 66620-7320. Telephone: 913-296-5514. Send one to WATER WELL OWNER and retain one for your records.