Sent to Leonard 7-20-77

Sent 7-20-77

USE TYPEWRITER OR BALL POINT PEN-PRESS FIRMLY, PRINT CLEARLY.

WATER WELL RECORD
KSA 82a-1201-1215

Kansas Department of Health and Environment-Division of Environment
(Water well Contractors)
Topeka, Kansas 66620

1. Location of well:	County: Saline	Fraction: NW 1/4 SE 1/4 SE 1/4	Section number: 33	Township number: T 15 S	Range number: R 4W E/W

2. Distance and direction from nearest town or city: 2 Miles N of Falun, Kans
Street address of well location if in city:

3. Owner of well: R.W.D. No. 1
R.R. or street: Falun, Kans 67442
City, state, zip code:

4. Locate with "X" in section below:

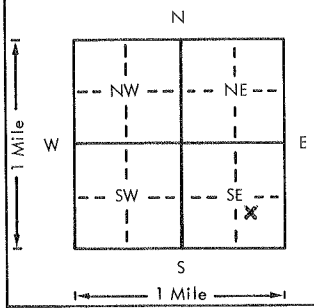

Sketch map:

6. Bore hole dia. 6 in. Completion date
Well depth 72 ft. 5-16-77

7. ___ Cable tool X Rotary ___ Driven ___ Dug
___ Hollow rod ___ Jetted ___ Bored ___ Reverse rotary

8. Use: ___ Domestic X Public supply ___ Industry
___ Irrigation ___ Air conditioning ___ Stock
___ Lawn ___ Oil field water ___ Other

9. Casing: Material ___ Height: Above or below
Threaded ___ Welded ___ Surface 12 in.
RMP ___ PVC X Weight ___ lbs./ft.
Dia. 4 in. to 72 ft. depth Wall Thickness: inches or
Dia. ___ in. to ___ ft. depth gage No. Sched 40

Feet below surface

5. Type and color of material	From	To
Alluvium:		
Clay, brown & gray	0	65
Gravel, medium to fine & silt, brown	65	70
Gravel, Coarse to fine & sand; some silt, brown	70	72
Ninnescah shale:		
Shale, red-gray & green	72	75

(Use a second sheet if needed)

10. Screen: Manufacturer's name Shop
Type slots Dia. 4"
Slot/gauze 3/32" Length 4'
Set between 68 ft. and 72 ft.
ft. and ft.
Gravel pack? Y Size range of material 3/8

11. Static water level: mo./day/yr.
8 ft. below land surface Date 5-16-77

12. Pumping level below land surfaces:
60 ft. after 6 hrs. pumping 10 g.p.m.
ft. after hrs. pumping g.p.m.
Estimated maximum yield 10 g.p.m.

13. Water sample submitted: mo./day/yr.
___ Yes X No Date

14. Well head completion:
___ Pitless adapter 12 Inches above grade

15. Well grouted? No Y
With: X Neat cement ___ Bentonite ___ Concrete
Depth: From 0 ft. to 20 ft.

16. Nearest source of possible contamination:
ft. 500' Direction S Type Creek
Well disinfected upon completion? X Yes ___ No

17. Pump: X Not installed
Manufacturer's name
Model number HP Volts
Length of drop pipe ft. capacity g.p.m.
Type:
___ Submersible ___ Turbine
___ Jet ___ Reciprocating
___ Centrifugal ___ Other

18. Elevation:

Topography:
___ Hill
___ Slope
___ Upland
X Valley

19. Remarks:
Test well - reamed for grouting in upper 20 ft. - waiting for order to grout.
Water sample pumped - 80 ppm Cl
25 grains hard

20. Water well contractor's certification:
This well was drilled under my jurisdiction and this report is true to the best of my knowledge and belief.
Hydraulic Drilling Co 126
Business name License No.
Address Salina Kans
Signed Authorized representative Date 7-11-77

T 15 R 4 E/W Sec 33 1/4 NW 1/4 SE 1/4

Forward the white, blue and pink copies to the Department of Health and Environment

Form WWC-5

MI-1023