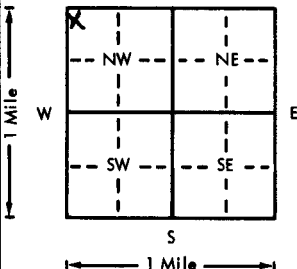
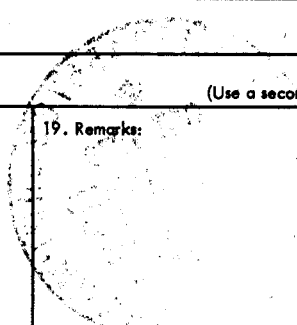


USE TYPEWRITER OR BALL POINT PEN—PRESS FIRMLY, PRINT CLEARLY.

WATER WELL RECORD
KSA 82a-1201-1215

Kansas Department of Health and Environment—Division of Environment
(Water well Contractors)
Topeka, Kansas 66620

B3B

1. Location of well: County: <u>WALLACE</u>		Fraction: <u>NW 1/4 NW 1/4 NW 1/4</u>		Section number: <u>9</u>	Township number: <u>T 15</u>	Range number: <u>S R 41</u>	<input checked="" type="checkbox"/> NW
2. Distance and direction from nearest town or city: <u>SHARON SPRINGS</u> Street address of well location if in city: <u>85 8W</u>				3. Owner of well: <u>KOEHN FARMS</u> R.R. or street: City, state, zip code: <u>SHARON SPRINGS KAN. 67758</u>			
4. Locate with "X" in section below: N W E S 1 Mile			Sketch map: 		6. Bore hole dia. <u>8 1/2</u> in. Completion date: <u>1-12-76</u> Well depth: <u>192</u> ft.		
5. Type and color of material			From	To	7. <input type="checkbox"/> Cable tool <input type="checkbox"/> Rotary <input type="checkbox"/> Driven <input type="checkbox"/> Dug <input type="checkbox"/> Hollow rod <input type="checkbox"/> Jetted <input type="checkbox"/> Bored <input checked="" type="checkbox"/> Reverse rotary		
<u>GRAVEL</u>			<u>113</u>	<u>132</u>	8. Use: <input type="checkbox"/> Domestic <input type="checkbox"/> Public supply <input type="checkbox"/> Industry <input checked="" type="checkbox"/> Irrigation <input type="checkbox"/> Air conditioning <input type="checkbox"/> Stock <input type="checkbox"/> Lawn <input type="checkbox"/> Oil field water <input type="checkbox"/> Other		
<u>CLAY, SANDSTONE</u>			<u>132</u>	<u>141</u>	9. Casing: Material <u>STEEL</u> Height: Above or below Threaded <input type="checkbox"/> Welded <input checked="" type="checkbox"/> Surface <u>12</u> in. RMP <input type="checkbox"/> PVC <input type="checkbox"/> Weight <u>36</u> lbs./ft. Dia. <u>1 1/2</u> in. to <u>105</u> ft. depth Wall Thickness: inches or Dia. <input type="checkbox"/> in. to <input type="checkbox"/> ft. depth Gauge No. <u>219</u>		
<u>GRAVEL</u>			<u>141</u>	<u>150</u>	10. Screen: Manufacturer's name <u>W. H. BROWN</u> Type <u>LUVER</u> Dia. <u>1 1/2</u> Slot/gauze <u>7/8 - 7</u> Length <u>90</u> Set between <u>105</u> ft. and <u>195</u> ft. ft. and ft.		
<u>GRAVEL, TRACE CLAY</u>			<u>150</u>	<u>162</u>	11. Static water level: _____ mo./day/yr. <u>1300</u> ft. below land surface Date <u>1-14-76</u>		
<u>SANDY CLAY</u>			<u>162</u>	<u>165</u>	12. Pumping level below land surfaces: <u>180</u> ft. after <u>6</u> hrs. pumping <u>1300</u> g.p.m. ft. after _____ hrs. pumping _____ g.p.m. Estimated maximum yield <u>1300</u> g.p.m.		
<u>GRAVEL</u>			<u>165</u>	<u>192</u>	13. Water sample submitted: _____ mo./day/yr. Yes <input type="checkbox"/> No <input checked="" type="checkbox"/> Date _____		
<u>Ocher</u>			<u>192</u>	<u>192</u>	14. Well head completion: <input checked="" type="checkbox"/> Pitless adapter _____ Inches above grade		
<u>BROCK 192'</u>					15. Well grouted? <u>YES</u> With: <input type="checkbox"/> Neat cement <input type="checkbox"/> Bentonite <input checked="" type="checkbox"/> Concrete Depth: From <u>0</u> ft. to <u>10</u> ft.		
					16. Nearest source of possible contamination: ft. _____ Direction _____ Type <u>None</u> Well disinfected upon completion? Yes <input type="checkbox"/> No <input checked="" type="checkbox"/>		
					17. Pump: _____ Not installed Manufacturer's name <u>WESTERN LARD PUMPS</u> Model number <u>6M</u> HP <u>60</u> Volts <u>220</u> Length of drop pipe <u>180</u> ft. capacity <u>200</u> g.p.m. Type: <input type="checkbox"/> Submersible <input checked="" type="checkbox"/> Turbine <input type="checkbox"/> Jet <input type="checkbox"/> Reciprocating <input type="checkbox"/> Centrifugal <input type="checkbox"/> Other		
18. Elevation:		19. Remarks: 					
Topography: <input type="checkbox"/> Hill <input type="checkbox"/> Slope <input checked="" type="checkbox"/> Upland <input type="checkbox"/> Valley		20. Water well contractor's certification: This well was drilled under my jurisdiction and this report is true to the best of my knowledge and belief. <u>L & H Drilling Co Inc 166</u> Business name _____ License No. _____ Address <u>Woodland Kansas</u> Signed <u>Bill Clifford</u> Date <u>3-4-76</u> Authorized representative					

T 15 R 41 S 41 NW 1/4 NE 1/4 SE 1/4 SW 1/4