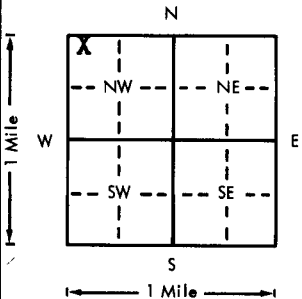


USE TYPEWRITER OR BALL POINT PEN-PRESS FIRMLY, PRINT CLEARLY.

WATER WELL RECORD
KSA 82a-1201-1215

Kansas Department of Health and Environment-Division of Environment
(Water well Contractors)
Topeka, Kansas 66620

BBB

Well # 1	County Wallace	Fraction NW 1/4 NW 1/4 NW 1/4	Section number 12	Township number T 15	Range number S R 41	E/W		
Distance and direction from nearest town or city: 1 1/2 mi. south & 4 1/2 mi. west of Sharon Springs Ks.		3. Owner of well: Smith Ranch		R.R. or street: % Joseph Smith			City, state, zip code: Tribune, Kans. 67879	
4. Locate with "X" in section below: Sketch map: 			6. Bore hole dia. 28 in. Completion date _____ Well depth 258 ft. 8-1-77			7. <input type="checkbox"/> Cable tool <input type="checkbox"/> Rotary <input type="checkbox"/> Driven <input type="checkbox"/> Dug <input type="checkbox"/> Hollow rod <input type="checkbox"/> Jetted <input type="checkbox"/> Bored <input checked="" type="checkbox"/> Reverse rotary		
5. Type and color of material			8. Use: <input type="checkbox"/> Domestic <input type="checkbox"/> Public supply <input type="checkbox"/> Industry <input checked="" type="checkbox"/> Irrigation <input type="checkbox"/> Air conditioning <input type="checkbox"/> Stock <input type="checkbox"/> Lawn <input type="checkbox"/> Oil field water <input type="checkbox"/> Other			9. Casing: Material steel Height: Above or below XXXX Threaded <input type="checkbox"/> Welded <input checked="" type="checkbox"/> Surface 12 in. RMP <input type="checkbox"/> PVC <input type="checkbox"/> Weight 40 lbs./ft. Dia 16 in. to 208 ft. depth Wall Thickness: inches or Dia 16 in. to 248 ft. depth gage No. 219		
			10. Screen: Manufacturer's name W. A. Brown Type Free-flo Dia. 16 Slot XXXX Length XXXX 10 Set between 248 ft. and 258 ft. ft. and _____ ft. Gravel pack? yes Size range of material 5/8"			11. Static water level: 7-15-77 mo./day/yr. 150 ft. below land surface Date _____		
Overburden			12. Pumping level below land surfaces: 200 ft. after 5 hrs. pumping 1500 g.p.m. ft. after _____ hrs. pumping _____ g.p.m. Estimated maximum yield 1800 g.p.m.			13. Water sample submitted: _____ mo./day/yr. Yes <input type="checkbox"/> No <input checked="" type="checkbox"/> Date _____		
Sand			14. Well head completion: <input type="checkbox"/> Pitless adapter 12 inches above grade			15. Well grouted? yes With <input type="checkbox"/> Neat cement <input type="checkbox"/> Bentonite <input checked="" type="checkbox"/> Concrete Depth: From 0 ft. to 10 ft.		
Clay & little lime			16. Nearest source of possible contamination: ft. _____ Direction _____ Type None Well disinfected upon completion? _____ Yes <input type="checkbox"/> No <input checked="" type="checkbox"/>			17. Pump: Not installed Manufacturer's name Worthington Model number 12M90 HP 75 Volts 440 Length of drop pipe 250 ft. capacity 1200 g.p.m. Type: <input type="checkbox"/> Submersible <input checked="" type="checkbox"/> Turbine <input type="checkbox"/> Jet <input type="checkbox"/> Reciprocating <input type="checkbox"/> Centrifugal <input type="checkbox"/> Other		
Sand			18. Elevation:			19. Remarks: BROCK 257		
Clay			20. Water well contractor's certification: This well was drilled under my jurisdiction and this report is true to the best of my knowledge and belief. ARK VALLEY PUMP & SUPPLY 123 Business name Box 235 Holly, Colo. License No. _____ Address _____ Signed Wm Smith Date _____ Authorized representative			18. Elevation:		

T 15
 R 41
 W 12
 Sec 12
 1/4 1/4 1/4