

USE TYPEWRITER OR BALL POINT PEN-PRESS FIRMLY, PRINT CLEARLY.

WESKAN

T R EW sec 1/4 1/4 1/4 No.


WATER WELL RECORD
KSA 82a-1201-1215

Kansas State Dept. Of Health
(Water Well Contractors)
Forbes-Bldg. 740
Topeka, Kansas 66620

ACC

1 Location of well: County WALLACE Township name SARON SPRINGS Fraction S¹/₂ - S¹/₂ NE Section number 17 Town number 15 Range number 41

Distance and direction from nearest town or city: _____
Street address of well location if in city: _____
3 Owner of well: EV ESTATE CHAS DREW
Address: GARDEN CITY, KANS

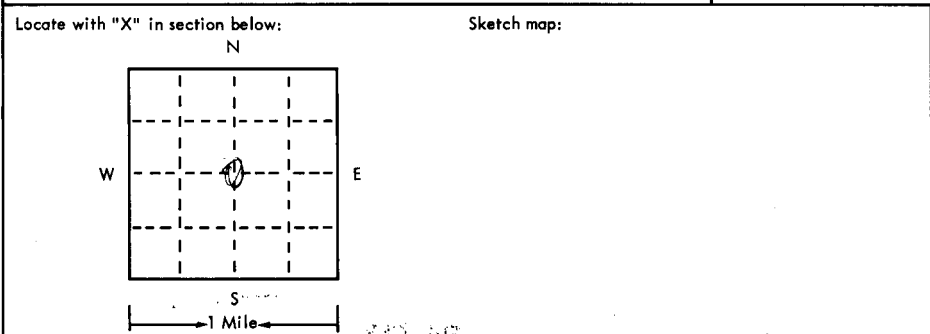

4 Well depth: 273 ft. Date of completion 4-4-75
Well diameter 16 in.
5 Cable tool Rotary Driven Dug
 Hollow rod Jetted Bored Reverse rotary
6 Use: Domestic Public supply Industry
 Irrigation Air conditioning Commercial
 Test well _____
7 Casing: Material Steel Height: above/below
Threaded Welded Surface 8 in.
Diam. 16 in. to 273 ft. depth Drive shoe Yes No
16 in. to _____ ft. depth

2	Type and color of material	From	To
	GRAVEL	118	138
	SANDSTONE	138	152
	GRAVEL	152	160
	SANDSTONE	160	167
	GRAVEL	167	176
	CLAY	176	179
	GRAVEL	179	203
	SANDSTONE	203	206
	GRAVEL	206	231
	CLAY	231	236
	GRAVEL	236	268
	SOAPSTONE	268	268
	S SHALE	268	273
	BROCK 266'		
	(use a second sheet if needed)		

8 Screen: Manufacturer WA. BROWN
Type M'illsoft Dia. 16"
Slot/gauze 1/8 Length 2 1/2'
Set between 120 ft. and 223 ft.
Fittings: Gravel pack Yes No Size range of material 3/8
9 Static water level: 118 ft. below land surface Date 4-4-75
10 Pumping level below land surfaces:
160 ft. after 8 hrs. pumping 1280 g.p.m.
_____ ft. after _____ hrs. pumping _____ g.p.m.
Estimated maximum yield 1800 g.p.m.

11 Water sample submitted:
 Yes No Date _____

12 Well head completion:
 Pitless adapter Inches above grade

13 Well grouted? Yes No
 Neat cement Bentonite _____
Depth: From 8' ft. to 10 ft.

14 Nearest source of possible contamination:
ft. _____ Direction _____ Type _____
Well disinfected upon completion? Yes No

15 Pump: Not installed
Manufacturer's name TAIT AYE
Model number _____ HP _____ Volts _____
Length of drop pipe 260 ft. capacity 1300 m.p.
Type:
 Submersible Turbine
 Jet Reciprocating
 Centrifugal Other

16 Remarks: elevation 3802 (TOP)

Topography:
 Hill
 Slope
 Upland
 Valley

17 Water well contractor's certification:
This well was drilled under my jurisdiction and this report is true to the best of my knowledge and belief.
Fast Supply Co Inc 144
Business name _____ License No. _____
Address Box 338 Gardenland
Signed Ray E. Egan Date 4-4-75
Authorized representative