


1 LOCATION OF WATER WELL: County: **Wallace** Fraction: **SE 1/4 SE 1/4 SW 1/4** Section Number: **23** Township Number: **T 15 S** Range Number: **R 41 EW**

Distance and direction from nearest town or city street address of well if located within city?  
**11 miles South 5 miles West of Sharon Springs, Kansas**

2 WATER WELL OWNER: **Smith Ranch**  
 RR#, St. Address, Box #: **Box 399**  
 City, State, ZIP Code: **Tribune, Kansas 67879**  
 Board of Agriculture, Division of Water Resources  
 Application Number: **36098**

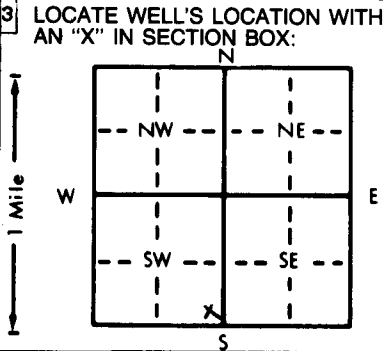

4 DEPTH OF COMPLETED WELL: **250** ft. ELEVATION: \_\_\_\_\_  
 Depth(s) Groundwater Encountered 1. **168** ft. 2. \_\_\_\_\_ ft. 3. \_\_\_\_\_ ft.  
 WELL'S STATIC WATER LEVEL: **168** ft. below land surface measured on mo/day/yr **9/21/82**  
 Pump test data: Well water was **203** ft. after **8** hours pumping **680** gpm  
 Est. Yield: **750** gpm; Well water was **208** ft. after **8** hours pumping **750** gpm  
 Bore Hole Diameter: **26** in. to **250** ft., and \_\_\_\_\_ in. to \_\_\_\_\_ ft.  
 WELL WATER TO BE USED AS:  
 1 Domestic  3 Feedlot  6 Oil field water supply  9 Dewatering  11 Injection well   
 2 **Irrigation**  4 Industrial  7 Lawn and garden only  10 Observation well  12 Other (Specify below) \_\_\_\_\_  
 Was a chemical/bacteriological sample submitted to Department? Yes \_\_\_\_\_ No ; If yes, mo/day/yr sample was submitted \_\_\_\_\_  
 Water Well Disinfected? Yes  No \_\_\_\_\_

5 TYPE OF BLANK CASING USED:  
 1 Steel  3 RMP (SR)  5 Wrought iron  8 Concrete tile CASING JOINTS: Glued \_\_\_\_\_ Clamped \_\_\_\_\_  
 2 PVC  4 ABS  6 Asbestos-Cement  9 Other (specify below)  **Welded**  
 \_\_\_\_\_  7 Fiberglass \_\_\_\_\_ Threaded \_\_\_\_\_  
 Blank casing diameter: **16** in. to **200** ft., Dia \_\_\_\_\_ in. to \_\_\_\_\_ ft., Dia \_\_\_\_\_ in. to \_\_\_\_\_ ft.  
 Casing height above land surface: **12** in., weight **42.05** lbs./ft. Wall thickness or gauge No. **.250**  
 TYPE OF SCREEN OR PERFORATION MATERIAL:  
 1 Steel  3 Stainless steel  5 Fiberglass  8 RMP (SR)  10 Asbestos-cement  
 2 Brass  4 Galvanized steel  6 Concrete tile  9 ABS  11 Other (specify) \_\_\_\_\_  
 \_\_\_\_\_  12 None used (open hole) \_\_\_\_\_  
 SCREEN OR PERFORATION OPENINGS ARE:  
 1 Continuous slot  3 Mill slot  5 Gauzed wrapped  8 Saw cut  11 None (open hole)  
 2 Louvered shutter  4 Key punched  6 Wire wrapped  9 Drilled holes  
 \_\_\_\_\_  7 Torch cut  **Other** (specify) **Extruded Bridge**  
 SCREEN-PERFORATED INTERVALS: From **200** ft. to **250** ft., From \_\_\_\_\_ ft. to \_\_\_\_\_ ft.  
 GRAVEL PACK INTERVALS: From **15** ft. to **250** ft., From \_\_\_\_\_ ft. to \_\_\_\_\_ ft.

6 GROUT MATERIAL:  1 Neat cement  **2 Cement grout**  3 Bentonite  4 Other \_\_\_\_\_  
 Grout Intervals: From **0** ft. to **15** ft., From \_\_\_\_\_ ft. to \_\_\_\_\_ ft., From \_\_\_\_\_ ft. to \_\_\_\_\_ ft.  
 What is the nearest source of possible contamination:  
 1 **Septic tank**  4 Lateral lines  7 Pit privy  10 Livestock pens  14 Abandoned water well  
 2 Sewer lines  5 Cess pool  8 Sewage lagoon  11 Fuel storage  15 Oil well/Gas well  
 3 Watertight sewer lines  6 Seepage pit  9 Feedyard  12 Fertilizer storage  16 Other (specify below) \_\_\_\_\_  
 \_\_\_\_\_  13 Insecticide storage \_\_\_\_\_  
 Direction from well? **Southeast** How many feet? **2600**

FROM	TO	LITHOLOGIC LOG	FROM	TO	LITHOLOGIC LOG
0	18	Clay	18	24	Gyp
24	39	Fine sand	39	44	Sand rock
44	58	Clay	58	90	Sand & Gravel
90	122	Fine sand	122	151	Sand
151	167	Clay	167	208	Sand
208	219	Clay	219	245	Sand
245	250	Clay yellow			

7 CONTRACTOR'S OR LANDOWNER'S CERTIFICATION: This water well was  (1) constructed  (2) reconstructed, or  (3) plugged under my jurisdiction and was completed on (mo/day/year) **10/1/82** and this record is true to the best of my knowledge and belief. Kansas Water Well Contractor's License No. **232** This Water Well Record was completed on (mo/day/yr) **10/25/82** under the business name of **Weishaar Drilling & Supply Inc.** by (signature) *[Signature]*

INSTRUCTIONS: Use typewriter or ball point pen, PLEASE PRESS FIRMLY and PRINT clearly. Please fill in blanks, underline or circle the correct answers. Send top three copies to Kansas Department of Health and Environment, Division of Environment, Environmental Geology Section, Topeka, KS 66620. Send one to WATER WELL OWNER and retain one for your records.

OFFICE USE ONLY  
15  
H  
41  
EW  
SEC 23  
SE 1/4 SW 1/4