


1] LOCATION OF WATER WELL: County: WALLACE Fraction: NW 1/4 NE 1/4 SW 1/4 Section Number: 28 Township Number: T 15 S Range Number: R 41 SW

Distance and direction from nearest town or city street address of well if located within city?
 2] WATER WELL OWNER: YOUNG CATTLE CO.
 RR#, St. Address, Box #: Rt 1 Box 57
 City, State, ZIP Code: TRIBUNE, KS 67879
 Board of Agriculture, Division of Water Resources
 Application Number: 31537

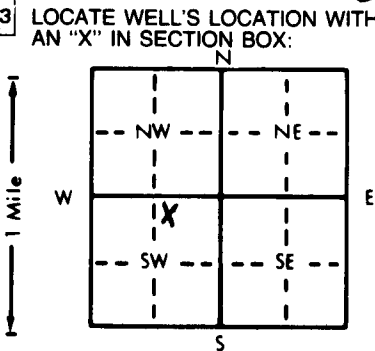

4] DEPTH OF COMPLETED WELL: 246 ft. ELEVATION: 3500
 Depth(s) Groundwater Encountered 1. 200 ft. 2. _____ ft. 3. _____ ft.
 WELL'S STATIC WATER LEVEL 200 ft. below land surface measured on mo/day/yr 5-8-91
 Pump test data: Well water was 240 ft. after 2 hours pumping 250 gpm
 Est. Yield 250 gpm: Well water was _____ ft. after _____ hours pumping _____ gpm
 Bore Hole Diameter: 26 in. to _____ ft., and _____ in. to _____ ft.
 WELL WATER TO BE USED AS:
 1 Domestic 3 Feedlot 5 Public water supply 8 Air conditioning 11 Injection well
 2 Irrigation 4 Industrial 6 Oil field water supply 9 Dewatering 12 Other (Specify below) _____
 7 Lawn and garden only 10 Monitoring well
 Was a chemical/bacteriological sample submitted to Department? Yes _____ No If yes, mo/day/yr sample was submitted _____
 Water Well Disinfected? Yes No _____

5] TYPE OF BLANK CASING USED:
 1 Steel 3 RMP (SR) 5 Wrought iron 8 Concrete tile CASING JOINTS: Glued Clamped _____
 2 PVC 4 ABS 6 Asbestos-Cement 9 Other (specify below) _____ Welded _____
 7 Fiberglass _____ Threaded _____
 Blank casing diameter: 12 in. to 206 ft., Dia _____ in. to _____ ft., Dia _____ in. to _____ ft.
 Casing height above land surface: 12 in., weight _____ lbs./ft. Wall thickness or gauge No. Sch 40
 TYPE OF SCREEN OR PERFORATION MATERIAL:
 1 Steel 3 Stainless steel 5 Fiberglass 7 PVC 10 Asbestos-cement
 2 Brass 4 Galvanized steel 6 Concrete tile 8 RMP (SR) 11 Other (specify) _____
 9 ABS 12 None used (open hole) _____
 SCREEN OR PERFORATION OPENINGS ARE:
 1 Continuous slot 3 Mill slot 5 Gauzed wrapped 8 Saw cut 11 None (open hole)
 2 Louvered shutter 4 Key punched 6 Wire wrapped 9 Drilled holes
 7 Torch cut 10 Other (specify) _____
 SCREEN-PERFORATED INTERVALS: From 206 ft. to 246 ft., From _____ ft. to _____ ft.
 GRAVEL PACK INTERVALS: From 20 ft. to 246 ft., From _____ ft. to _____ ft.

6] GROUT MATERIAL: 1 Neat cement 2 Cement grout 3 Bentonite 4 Other _____
 Grout Intervals: From 0 ft. to 20 ft., From _____ ft. to _____ ft., From _____ ft. to _____ ft.
 What is the nearest source of possible contamination:
 1 Septic tank 4 Lateral lines 7 Pit privy 10 Livestock pens 14 Abandoned water well
 2 Sewer lines 5 Cess pool 8 Sewage lagoon 11 Fuel storage 15 Oil well/Gas well
 3 Watertight sewer lines 6 Seepage pit 9 Feedyard 12 Fertilizer storage 16 Other (specify below) _____
 13 Insecticide storage
 Direction from well? WEST
 How many feet? 290

FROM	TO	LITHOLOGIC LOG	FROM	TO	PLUGGING INTERVALS
0	11	TOP SOIL & CLAY	165	181	SANDY CLAY & 4' SAND
11	16	LIMESTONE	181	193	SAND (FINE) & 5' CLAY
16	33	LIMESTONE (HARD)	193	202	CLAY
33	49	LIMESTONE & LITTLE CLAY (HARD)	202	206	SAND (medium)
49	53	LIMESTONE	206	210	CLAY
53	66	SAND & GRAVEL	210	214	SAND (medium)
66	76	SANDY CLAY	214	231	SAND & GRAVEL (med to cr) 3' CLAY
76	82	SAND (medium)	231	240	SAND & GRAVEL (med to coarse)
82	99	SANDY CLAY	240	245	CLAY
99	115	CLAY & SANDY CLAY (HARD)	245	246	SHALE
115	123	SANDY CLAY & LITTLE SAND			
123	137	SAND			
137	148	SANDY CLAY			
148	155	SAND & SANDY CLAY			
155	165	CLAY			

7] CONTRACTOR'S OR LANDOWNER'S CERTIFICATION: This water well was (1) constructed, (2) reconstructed, or (3) plugged under my jurisdiction and was completed on (mo/day/year) 5-10-91 and this record is true to the best of my knowledge and belief. Kansas Water Well Contractor's License No. 473 This Water Well Record was completed on (mo/day/yr) 5-29-91 under the business name of TYLER WATER WELL SERVICE by (signature) [Signature]