

# ARAPAHOE SE

USE TYPEWRITER OR BALL POINT PEN-PRESS FIRMLY, PRINT CLEARLY.


T R EW sec 1/4 1/4 1/4 No.

WATER WELL RECORD  
KSA 82a-1201-1215

Kansas State Dept. Of Health  
(Water Well Contractors)  
Forbes-Bldg. 740  
Topeka, Kansas 66620

## ABA

1 Location of well: County <b>Wallace</b>	Township name <b>Weskan</b>	Fraction <b>NE-NW of NE</b>	Section number <b>7</b>	Town number <b>15</b>	Range number <b>42</b>
Distance and direction from nearest town or city: <b>6 mi. south, 4 mi. west, &amp; 1/2 mi. west of Weskan</b> Street address of well location if in city:			3 Owner of well: <b>Leroy Hinricks</b> Address: <b>Weskan, Kansas</b>		

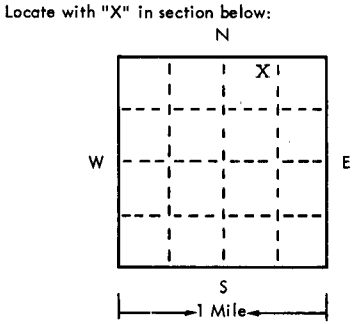

Sketch map:

4 Well depth: 280 ft. Date of completion 4-5-75  
Well diameter 28 in.  
5  Cable tool  Rotary  Driven  Dug  
 Hollow rod  Jetted  Bored  Reverse rotary  
6 Use:  Domestic  Public supply  Industry  
 Irrigation  Air conditioning  Commercial  
 Test well

7 Casing: Material steel height: above  Surface 12 in.  
Threaded  Welded  Surface 12 in.  
Diam. \_\_\_\_\_ Weight \_\_\_\_\_ lbs./ft. \_\_\_\_\_  
16 in. to 280 ft. depth Drive shoe?  Yes  No  
Dia. to \_\_\_\_\_ ft. depth

2	Type and color of material	From	To
	Overburden	0	152
	Sand, Gravel, & Clay streaked	152	172
	Sand	172	212
	sand & clay streaked	212	263
	Sand & clay <b>IS ROCK</b>	263	280
(use a second sheet if needed)			

8 Screen:  
Manufacturer W. A. Brown  
Type Free Flo Dia. x2 16  
Slot/gauze slot Length 2  
Set between 240 ft. and 280 ft.  
Fittings:  
Gravel pack  Yes  No Size range of material 5/8

9 Static water level:  
180 ft. below land surface Date 4-12-75

10 Pumping level below land surfaces:  
254 ft. after 4 hrs. pumping 1000 g.p.m.  
\_\_\_\_\_ ft. after \_\_\_\_\_ hrs. pumping \_\_\_\_\_ g.p.m.  
Estimated maximum yield 1000 g.p.m.

11 Water sample submitted:  
 Yes  No Date \_\_\_\_\_

12 Well head completion:  
 Pitless adapter  Inches above grade

13 Well grouted?  Yes  No  
 Neat cement  Bentonite  
Depth: From \_\_\_\_\_ ft. to 10 ft.

14 Nearest source of possible contamination: None  
ft. \_\_\_\_\_ Direction \_\_\_\_\_ Type \_\_\_\_\_  
Well disinfected upon completion?  Yes  No

15 Pump:  Not installed  
Manufacturer's name \_\_\_\_\_  
Model number \_\_\_\_\_ HP \_\_\_\_\_ Volts \_\_\_\_\_  
Length of drop pipe \_\_\_\_\_ ft. capacity \_\_\_\_\_ g.m.p.  
Type:  
 Submersible  Turbine  
 Jet  Reciprocating  
 Centrifugal  Other

16 Remarks: elevation **3909 (TOPO)**

Topography: Level Land  
 Hill  
 Slope  
 Upland  
 Valley

17 Water well contractor's certification:  
This well was drilled under my jurisdiction and this report is true to the best of my knowledge and belief.  
**Ark Valley Pump & Supply 123**  
Business name \_\_\_\_\_ License No. \_\_\_\_\_  
Address Holly, Colo  
Signed W. Smith Date 10-3-75  
Authorized representative

15 42 W 7 NE NW NE