


1 LOCATION OF WATER WELL: County: WALLACE Fraction SE 1/4 SE 1/4 SW 1/4 Section Number 7 Township Number T 15 S Range Number R 42 E/W

Distance and direction from nearest town or city street address of well if located within city? 8 MILES SOUTH AND 3 1/2 WEST OF WESKAN, KANSAS

2 WATER WELL OWNER: VERNON D AKERS RR#, St. Address, Box #: R 1 BOX 26 City, State, ZIP Code: WESKAN KS 67762-9718 Board of Agriculture, Division of Water Resources Application Number:

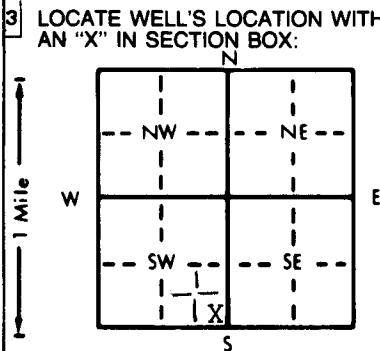

3 LOCATE WELL'S LOCATION WITH AN 'X' IN SECTION BOX: 4 DEPTH OF COMPLETED WELL: 198 ft. ELEVATION: WELL'S STATIC WATER LEVEL: 140 ft. below land surface measured on mo/day/yr

5 TYPE OF CASING USED: 1 Steel, 3 RMP (SR), 2 PVC, 4 ABS, 5 Wrought iron, 8 Concrete tile, 6 Asbestos-Cement, 9 Other (specify below), 7 Fiberglass, CASING JOINTS: Glued, Clamped, Welded (X), Threaded. Blank casing diameter: 16 in. to 16 in. Dia. Casing height above land surface: 36 in., weight lbs./ft. Wall thickness or gauge No. TYPE OF SCREEN OR PERFORATION MATERIAL: 1 Steel, 3 Stainless steel, 2 Brass, 4 Galvanized steel, 5 Fiberglass, 8 RMP (SR), 6 Concrete tile, 9 ABS, 10 Asbestos-cement, 11 Other (specify). SCREEN OR PERFORATION OPENINGS ARE: 1 Continuous slot, 3 Mill slot, 2 Louvered shutter, 4 Key punched, 5 Gauzed wrapped, 6 Wire wrapped, 7 Torch cut, 8 Saw cut, 9 Drilled holes, 11 None (open hole). SCREEN-PERFORATED INTERVALS: From N/A ft. to N/A ft. GRAVEL PACK INTERVALS: From ft. to ft.

6 GROUT MATERIAL: 1 Neat cement, 2 Cement grout, 3 Bentonite, 4 Other. Grout Intervals: From 6 ft. to 3 ft. From ft. to ft. From ft. to ft. What is the nearest source of possible contamination: 1 Septic tank, 4 Lateral lines, 7 Pit privy, 10 Livestock pens, 14 Abandoned water well, 2 Sewer lines, 5 Cess pool, 8 Sewage lagoon, 11 Fuel storage, 15 Oil well/Gas well, 3 Watertight sewer lines, 6 Seepage pit, 9 Feedyard, 12 Fertilizer storage, 16 Other (specify below) NONE

Direction from well? How many feet? FROM TO LITHOLOGIC LOG FROM TO PLUGGING INTERVALS

			198	140	CLEAN SAND (CHLORINATED)
			140	6	SAND & CLAY
			6	3	BENTONITE
			3	0	TOP SOIL

7 CONTRACTOR'S OR LANDOWNER'S CERTIFICATION: This water well was (1) constructed, (2) reconstructed, or (3) plugged under my jurisdiction and was completed on (mo/day/year) JANUARY 21, 1994 and this record is true to the best of my knowledge and belief. Kansas Water Well Contractor's License No. 507. This Water Well Record was completed on (mo/day/yr) JANUARY 26, 1994 under the business name of WESTERN SPRINKLERS, INC by (signature) [Signature]