


1 LOCATION OF WATER WELL: County: Wallace Fraction: NW 1/4 NW 1/4 NW 1/4 Section Number: 30 Township Number: T 15 S Range Number: R 42 E

Distance and direction from nearest town or city street address of well if located within city?
1/2 W 9 1/2 S of Westkan

2 WATER WELL OWNER: John Welsh
 RR#, St. Address, Box #: _____
 City, State, ZIP Code: Westkan, Kansas 67762
 Board of Agriculture, Division of Water Resources
 Application Number: _____

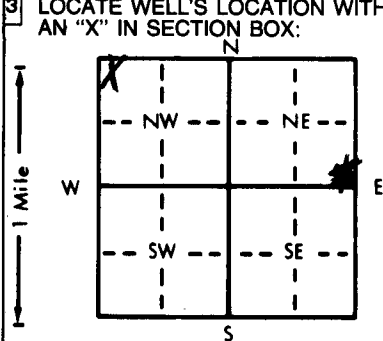

4 DEPTH OF COMPLETED WELL: 230 ft. ELEVATION: _____
 Depth(s) Groundwater Encountered 1. _____ ft. 2. _____ ft. 3. _____ ft.
 WELL'S STATIC WATER LEVEL: 200 ft. below land surface measured on 6/29/81
 Pump test data: Well water was _____ ft. after _____ hours pumping _____ gpm
 Est. Yield: Not tested gpm: Well water was _____ ft. after _____ hours pumping _____ gpm
 Bore Hole Diameter: 8 in. to 230 ft., and _____ in. to _____ ft.
 WELL WATER TO BE USED AS:
 Domestic 3 Feedlot 6 Oil field water supply 9 Dewatering 12 Other (Specify below)
 2 Irrigation 4 Industrial 7 Lawn and garden only 10 Observation well
 Was a chemical/bacteriological sample submitted to Department? Yes _____ No ; If yes, mo/day/yr sample was submitted _____
 Water Well Disinfected? Yes No _____

5 TYPE OF BLANK CASING USED:
 1 Steel RMP (SR)
 2 PVC 4 ABS
 3 Wrought iron 8 Concrete tile CASING JOINTS: Glued Clamped _____
 6 Asbestos-Cement 9 Other (specify below) Welded _____
 7 Fiberglass Threaded _____
 Blank casing diameter: 5 in. to 210 ft., Dia _____ in. to _____ ft., Dia _____ in. to _____ ft.
 Casing height above land surface: 18 in., weight 1 1/2 lbs./ft. Wall thickness or gauge No. 1/4 250
 TYPE OF SCREEN OR PERFORATION MATERIAL:
 1 Steel 3 Stainless steel 5 Fiberglass RMP (SR)
 2 Brass 4 Galvanized steel 6 Concrete tile 9 ABS 10 Asbestos-cement 11 Other (specify) _____
 12 None used (open hole)
 SCREEN OR PERFORATION OPENINGS ARE:
 1 Continuous slot 3 Mill slot 5 Gauzed wrapped Saw cut 11 None (open hole)
 2 Louvered shutter 4 Key punched 6 Wire wrapped 9 Drilled holes
 7 Torch cut 10 Other (specify) _____
 SCREEN-PERFORATED INTERVALS: From 5 ft. to 210 ft., From _____ ft. to _____ ft.
 From 210 ft. to 230 ft., From _____ ft. to _____ ft.
 GRAVEL PACK INTERVALS: From 18 ft. to 230 ft., From _____ ft. to _____ ft.
 From _____ ft. to _____ ft., From _____ ft. to _____ ft.

6 GROUT MATERIAL: Neat cement 2 Cement grout 3 Bentonite 4 Other _____
 Grout Intervals: From 4 ft. to 18 ft., From _____ ft. to _____ ft., From _____ ft. to _____ ft.
 What is the nearest source of possible contamination:
 1 ~~Septic tank~~ 617 4 Lateral lines 7 Pit privy 10 Livestock pens Abandoned water well
 2 Sewer lines 5 Cess pool 8 ~~Sewage lagoon~~ 11 Fuel storage 15 Oil well/Gas well
 3 Watertight sewer lines 6 ~~Seepage pit~~ 9 Feedyard 12 Fertilizer storage 16 Other (specify below)
 13 Insecticide storage
 Direction from well? North How many feet? 50

FROM	TO	LITHOLOGIC LOG	FROM	TO	LITHOLOGIC LOG
0	42	top soil			
42	66	sandy clay			
66	88	sand clay & sand rock stripes			
88	141	sand & sand rock stripes			
141	166	sand rock & sand stripes			
166	173	sand clay			
173	181	sand rock			
181	191	sand rock & sand stripes			
191	218	sand & sand rock stripes			
218	223	sand			
223	230	oker & shale			

7 CONTRACTOR'S OR LANDOWNER'S CERTIFICATION: This water well was constructed, (2) reconstructed, or (3) plugged under my jurisdiction and was completed on (mo/day/year) 6/29/81 and this record is true to the best of my knowledge and belief. Kansas Water Well Contractor's License No. 139 This Water Well Record was completed on (mo/day/yr) 8/13/81 under the business name of Bartell Drilling by (signature) Daylene Bartell Group

INSTRUCTIONS: Use typewriter or ball point pen, PLEASE PRESS FIRMLY and PRINT clearly. Please fill in blanks, underline or circle the correct answers. Send top three copies to Kansas Department of Health and Environment, Division of Environment, Environmental Geology Section, Topeka, KS 66620. Send one to WATER WELL OWNER and retain one for your records.