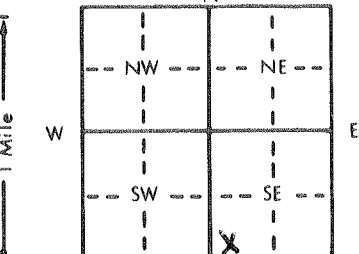


1 LOCATION OF WATER WELL:		Fraction		Section Number		Township Number		Range Number	
County: <u>SALINE</u>		<u>SW 1/4 SW 1/4 SE 1/4</u>		<u>36</u>		<u>T 15 S</u>		<u>R 5 E</u>	
Distance and direction from nearest town or city street address of well if located within city?									
<u>3 miles west &amp; 2 miles north of FALUN KS</u>									
2 WATER WELL OWNER: <u>SMOKY HILL RANG RANGE</u>									
RR#, St. Address, Box # <u>8429 W. FANNALLY ROAD</u>									
City, State, ZIP Code <u>SALINA, KS 67401</u>									
Board of Agriculture, Division of Water Resources									
Application Number:									
3 LOCATE WELL'S LOCATION WITH AN "X" IN SECTION BOX:					4 DEPTH OF COMPLETED WELL: <u>28</u> ft. ELEVATION:				
					Depth(s) Groundwater Encountered 1. .... ft. 2. .... ft. 3. .... ft.				
					WELL'S STATIC WATER LEVEL <u>5.5</u> ft. below land surface measured on mo/day/yr <u>10-14-97</u>				
					Pump test data: Well water was .... ft. after .... hours pumping .... gpm				
					Est. Yield .... gpm: Well water was .... ft. after .... hours pumping .... gpm				
					Bore Hole Diameter <u>4</u> in. to .... ft., and .... in. to .... ft.				
					WELL WATER TO BE USED AS:				
					1 Domestic 3 Feedlot 6 Oil field water supply 9 Dewatering 12 Other (Specify below)				
					2 Irrigation 4 Industrial 7 Lawn and garden only 10 Monitoring well				
					Was a chemical/bacteriological sample submitted to Department? Yes.....No.....; If yes, mo/day/yr sample was submitted				
					Water Well Disinfected? <u>Yes</u> No				
5 TYPE OF BLANK CASING USED:									
1 Steel 3 RMP (SR) 5 Wrought iron 8 Concrete tile CASING JOINTS: Glued ..... Clamped .....									
2 PVC 4 ABS 6 Asbestos-Cement 9 Other (specify below) Welded .....									
Blank casing diameter <u>3.5</u> in. to .... ft., Dia. .... in. to .... ft., Dia. .... in. to .... ft.									
Casing height above land surface .... in., weight .... lbs./ft. Wall thickness or gauge No. ....									
TYPE OF SCREEN OR PERFORATION MATERIAL:									
1 Steel 3 Stainless steel 5 Fiberglass 8 RMP (SR) 10 Asbestos-cement									
2 Brass 4 Galvanized steel 6 Concrete tile 9 ABS 11 Other (specify) .....									
12 None used (open hole)									
SCREEN OR PERFORATION OPENINGS ARE:									
1 Continuous slot 3 Mill slot 5 Gauzed wrapped 8 Saw cut 11 None (open hole)									
2 Louvered shutter 4 Key punched 7 Torch cut 9 Drilled holes									
10 Other (specify) .....									
SCREEN-PERFORATED INTERVALS: From .... ft. to .... ft., From .... ft. to .... ft.									
From .... ft. to .... ft., From .... ft. to .... ft.									
GRAVEL PACK INTERVALS: From .... ft. to .... ft., From .... ft. to .... ft.									
From .... ft. to .... ft., From .... ft. to .... ft.									
6 GROUT MATERIAL:									
1 Neat cement 2 Cement grout 3 Bentonite 4 Other									
Grout Intervals: From .... ft. to .... ft., From .... ft. to .... ft., From .... ft. to .... ft.									
What is the nearest source of possible contamination:									
1 Septic tank 4 Lateral lines 7 Pit privy 10 Livestock pens 14 Abandoned water well									
2 Sewer lines 5 Cess pool 8 Sewage lagoon 11 Fuel storage 15 Oil well/Gas well									
3 Watertight sewer lines 6 Seepage pit 9 Feedyard 12 Fertilizer storage 16 Other (specify below) <u>OLD BASEMENT</u>									
13 Insecticide storage									
Direction from well? <u>NORTH</u> How many feet? <u>25</u>									
FROM TO LITHOLOGIC LOG FROM TO PLUGGING INTERVALS									
<u>28 5.5 REMOVED LINING TO 5'</u>									
<u>5.5 5 REMOVED WATER</u>									
<u>5 0 COARSE SAND (216.37 CU FT)</u>									
<u>BENTONITE CHIPS (4.81 CU FT)</u>									
<u>CLAYS (48.08 CU FT)</u>									
7 CONTRACTOR'S OR LANDOWNER'S CERTIFICATION: This water well was (1) constructed, (2) reconstructed, or (3) <u>plugged</u> under my jurisdiction and was completed on (mo/day/year) <u>10-14-97</u> and this record is true to the best of my knowledge and belief. Kansas									
Water Well Contractor's License No. <u>559</u> This Water Well Record was completed on (mo/day/yr) <u>10-18-97</u>									
under the business name of <u>MARTIN WATER WELL DRILLING</u> by (signature) <u>J. E. Martin</u>									
INSTRUCTIONS: Use typewriter or ball point pen. PLEASE PRESS FIRMLY and PRINT clearly. Please fill in blanks, underline or circle the correct answers. Send top three copies to Kansas Department of Health and Environment, Bureau of Water, Topeka, Kansas 66620-0001. Telephone: 913-296-5545. Send one to WATER WELL OWNER and retain one for your records.									