

1	LOCATION OF WATER WELL:	Fraction	Section Number	Township Number	Range Number
County:	Saline	se $\frac{1}{4}$ sw $\frac{1}{4}$ sw $\frac{1}{4}$	3	T 15 S	R 5 E/W

Distance and direction from nearest town or city street address of well if located within city?

1/4^m South of Brookville

2	WATER WELL OWNER:
---	-------------------


Nowak Construction

RR#, St. Address, Box # : 200 S. Goddard P.O. Box 218
City, State, ZIP Code : Goddard, Ks. 67052

Board of Agriculture, Division of Water Resources
Application Number:

3	LOCATE WELL'S LOCATION WITH	4	DEPTH OF COMPLETED WELL 30 ft. ELEVATION:
---	-----------------------------	---	---

AN "X" IN SECTION BOX:

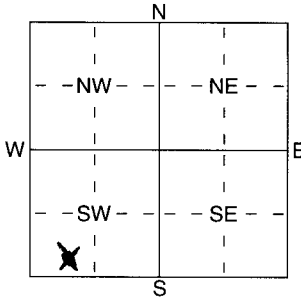

Depth(s) Groundwater Encountered 1 ft. 2 ft. 3 ft.
WELL'S STATIC WATER LEVEL **15** ft. below land surface measured on mo/day/yr
Pump test data: Well water was ft. after hours pumping gpm
Est. Yield gpm Well water was ft. after hours pumping gpm
WELL WATER TO BE USED AS: 5 Public water supply 8 Air conditioning 11 Injection well
1 Domestic 3 Feedlot 6 Oil field water supply 9 Dewatering **X2** Other (Specify below)
2 Irrigation 4 Industrial 7 Domestic (lawn & garden) 10 Monitoring well **Temp. well**

Was a chemical/bacteriological sample submitted to Department? Yes No **X**...; If yes, mo/day/yr sample was submitted
Water Well Disinfected? Yes **X** No

5	TYPE OF BLANK CASING USED:
---	----------------------------

1 Steel
☒ PVC
3 RMP (SR)
4 ABS

5 Wrought iron
6 Asbestos-Cement
7 Fiberglass

8 Concrete tile
9 Other (specify below)

CASING JOINTS: Glued **X** Clamped
Welded
Threaded

Blank casing diameter **5** in. to **10** ft., Dia in. to ft., Dia in. to ft.

Casing height above land surface **12** in., weight **2.37** lbs./ft. Wall thickness or gauge No. **.214**

TYPE OF SCREEN OR PERFORATION MATERIAL:

1 Steel	3 Stainless Steel
2 Brass	4 Galvanized Steel

5 Fiberglass
6 Concrete tile

~~7X~~PVC
8 RMP (SR)
9 ABS

10 Asbestos-Cement
11 Other (Specify)
12 None used (open hole)

SCREEN OR PERFORATION OPENINGS ARE:

1 Continuous slot ☒ Mill slot
2 Louvered shutter 4 Key punched

5 Guazed wrapped
6 Wire wrapped
7 Torch cut

8 Saw cut
9 Drilled holes
10 Other (specify)ft.
11 None (open hole)

SCREEN-PERFORATED INTERVALS: From 10 ft. to 30 ft., From _____ ft. to _____ ft.

From ft. to ft., From ft. to ft.

GRAVEL PACK INTERVALS: From 15 ft. to 30 ft. From _____ ft. to _____ ft.
From _____ ft. to _____ ft. From _____ ft. to _____ ft.

6	GROUT MATERIAL:
---	-----------------

1 Neat cement

2 Cement grout

X Bentonite

4 Other

Grout Intervals: From 0 ft. to 15 ft., From _____ ft. to _____ ft., From _____ ft. to _____ ft.

What is the nearest source of possible contamination:

1 Septic tank	4 Lateral lines
2 Sewer lines	5 Cess pool
3 Watertight sewer lines	6 Seepage pit

7 Pit privy
☒ Sewage lagoon
 9 Feedyard

10 Livestock pens	14 Abandoned water well
11 Fuel storage	15 Oil well/Gas well
12 Fertilizer storage	16 Other (specify below)
13 Insecticide storage	

Direction from well? NORTH

NORTH

How many feet? **75Ft. north**

[illegible]

7. CONTRACTOR'S OR LANDOWNER'S CERTIFICATION: This water well was (1) constructed, (2) reconstructed, or (3) plugged under my jurisdiction and was completed on (mo/day/year) 4/9/04 and this record is true to the best of my knowledge and belief. Kansas Water Well Contractor's Licence No 138 This Water Well Record was completed on (mo/day/yr) 4/27/04 under the business name of Peterson Irrigation, Inc. by (signature) M. Peterson