

LOCATION OF WATER WELL:	Fraction	Section Number	Township Number	Range Number
County: Saline	SE ¼ NW ¼ SW ¼	3	T 15 S	R 5

Distance and direction from nearest town or city street address of well if located within city?

128 Anderson, Brookville, KS


WATER WELL OWNER:	Steve Riedel	
RR#, St. Address, Box # :	Box 141	Board of Agriculture, Division of Water Resources
City, State, ZIP Code :	Brookville, KS 67425	Application Number:

LOCATE WELL'S LOCATION WITH AN "X" IN SECTION BOX: 4 DEPTH OF COMPLETED WELL: 41 ft. ELEVATION: \_\_\_\_\_

Z

4. DEPTH OF COMPLETED WELL: 41 ft. ELEVATION: \_\_\_\_\_

Depth(s) Groundwater Encountered: 1 ft 2 ft 3 ft

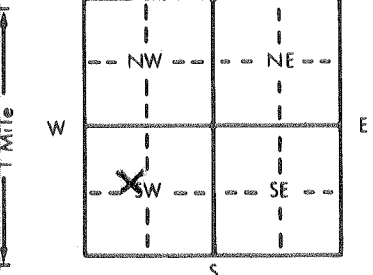

WELL'S STATIC WATER LEVEL ..... 8 ..... ft. below land surface measured on mo/day/yr 5-14-88

Pump test data: Well water was ..... ft. after ..... hours pumping ..... gpm

Est. Yield 4-6 gpm: Well water was 30 ft. after 1-2 hours pumping 2 gpm  
 Pump Hole Diameter 8 in. to 47 ft. and in to 4 ft.

WELL WATER TO BE USED AS:    5 Public water supply    8 Air conditioning    11 Injection well

1 Domestic	3 Feedlot	6 Oil field water supply	9 Dewatering	12 Other (Specify below)
------------	-----------	--------------------------	--------------	--------------------------

2 Irrigation      4 Industrial      7 Lawn and garden only      10 Observation well      .....

Was a chemical/bacteriological sample submitted to Department? Yes.....No.....X., If yes, mo/day/yr sample was submitted

Water Well Disinfected? Yes X No

5 TYPE OF BLANK CASING USED: 5 Wrought iron 8 Concrete tile CASING JOINTS: Glued . . . . . Clamped . . . . .

1 Steel	3 RMP (SR)	6 Asbestos-Cement	9 Other (specify below)	Welded . . . . .
2 <u>PVC</u>	4 ABS	7 Fiberglass		Threaded . . . . .

Blank casing diameter . . . . . 5 . . . . in. to . . . . 30 . . . . ft., Dia . . . . . in. to . . . . . ft., Dia . . . . . in. to . . . . . ft.

Casing height above land surface. . . . . 12. . . . in., weight . . . . . 2.91 . . . . . lbs./ft. Wall thickness or gauge No. . . . . 20 . . . . .

TYPE OF SCREEN OR PERFORATION MATERIAL : . . . . . 7 PVC . . . . . 10 Asbestos-cement

1 Steel	3 Stainless steel	5 Fiberglass	7 RMP (SR)	11 Other (specify) . . . . .
2 Brass	4 Galvanized steel	6 Concrete tile	9 ABS	12 None used (open hole)

SCREEN OR PERFORATION OPENINGS ARE: 5 Gauzed wrapped 8 Saw cut 11 None (open hole)

1 Continuous slot	3 Mill slot	6 Wire wrapped	9 Drilled holes
-------------------	-------------	----------------	-----------------

2 Louvered shutter      4 Key punched      7 Torch cut      10 Other (specify) \_\_\_\_\_

SCREEN-PERFORATED INTERVALS: From 30 ft to 47 ft From \_\_\_\_\_ ft to \_\_\_\_\_ ft

From ..... ft. to ..... ft., From ..... ft. to ..... ft.

GRAVEL PACK INTERVALS: From . . . . . 20 . . . . . ft. to . . . . . 41 . . . . . ft., From . . . . . ft. to . . . . . ft.

		From	ft. to	ft., From	ft. to	ft.
6	GROUT MATERIAL:	1. Neat cement	2. Cement grout	3. Bentonite	4. Other	

Grout Intervals: From 0 ft. to 20 ft., From . ft. to . ft., From . ft. to . ft.

What is the nearest source of possible contamination: 10 Livestock pens 14 Abandoned water well

1 Septic tank	4 Lateral lines	7 Pit privy	11 Fuel storage	15 Oil well/Gas well
2 Sewer lines	5 Cess pool	8 Sewage lagoon	12 Fertilizer storage	16 Other (specify below)

2 Sewer lines	5 Cess pool	8 Sewage lagoon	12 Fertilizer storage	15 Other (specify below)
3 Watertight sewer lines	6 Seepage pit	9 Feedyard	13 Insecticide storage	

Direction from well? South How many feet? 100

FROM	TO	LITHOLOGIC LOG	FROM	TO	LITHOLOGIC LOG
0	3	Top Soil			

3	9	Brown Clay			
---	---	------------	--	--	--

9	15	Fine Sands			
15	26	Clay			

15	36	Clay			
36	40	Creek Sand			

40	41	Shale			
----	----	-------	--	--	--






7. CONTRACTOR'S OR LANDOWNER'S CERTIFICATION: This water well was (1) constructed, (2) reconstructed, or (3) plugged under my jurisdiction and was installed in accordance with the applicable regulatory requirements. I certify that the information provided on this form is true and correct, and this record is true to the best of my knowledge and belief. Kansas

Water Well Contractor's License No. 138 This Water Well Record was completed on (mo/day/yr) 5-18-88

under the business name of Peterson Irrigation, Inc. by (signature) Melvin Peterson

INSTRUCTIONS: Use typewriter or ball point pen. PLEASE PRESS FIRMLY and PRINT clearly. Please fill in blanks, underline or circle the correct answers. Send top three copies to Kansas Department of Health and Environment, Bureau of Water Protection, Topeka, Kansas 66620-7320, Telephone: 913-862-9360. Send one to WATER WELL OWNER and retain one for your

records.