


WATER WELL RECORD Form WWC-5 KSA 82a-1212

1 LOCATION OF WATER WELL: County: Ellsworth Fraction: SE 1/4 SW 1/4 NW 1/4 Section Number: 30 Township Number: T 15 S Range Number: R 7 W/W

2 WATER WELL OWNER: KDHE RR#, St. Address, Box #: Forbes Field, Building 740 City, State, ZIP Code: Topeka, KS 66620 Board of Agriculture, Division of Water Resources Application Number:

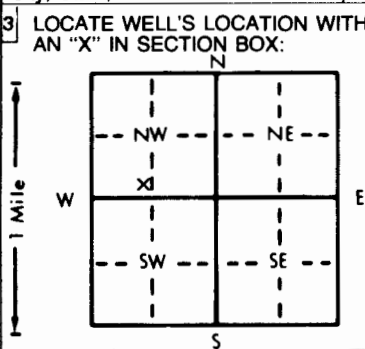

3 LOCATE WELL'S LOCATION WITH AN 'X' IN SECTION BOX: 4 DEPTH OF COMPLETED WELL: 113 ft. ELEVATION: WELL'S STATIC WATER LEVEL: 103 ft. below land surface measured on mo/day/yr

5 TYPE OF BLANK CASING USED: 1 Steel, 2 PVC, 3 RMP (SR), 4 ABS, 5 Wrought iron, 6 Asbestos-Cement, 7 Fiberglass, 8 Concrete tile, 9 Other (specify below), CASING JOINTS: Glued, Clamped, Welded, Threaded. X. Blank casing diameter: 2 in. to 103 in. Dia. Casing height above land surface: 0 in., weight lbs./ft. Wall thickness or gauge No. Sch. 40

6 GROUT MATERIAL: 1 Neat cement, 2 Cement grout, 3 Bentonite, 4 Other Cement bentonite. Grout Intervals: From 100 ft. to 0 ft. What is the nearest source of possible contamination: 1 Septic tank, 2 Sewer lines, 3 Watertight sewer lines, 4 Lateral lines, 5 Cess pool, 6 Seepage pit, 7 Pit privy, 8 Sewage lagoon, 9 Feedyard, 10 Livestock pens, 11 Fuel storage, 12 Fertilizer storage, 13 Insecticide storage, 14 Abandoned water well, 15 Oil well/Gas well, 16 Other (specify below) Salt pile

Direction from well? How many feet? LITHOLOGIC LOG: FROM TO LITHOLOGIC LOG FROM TO PLUGGING INTERVALS

FROM	TO	LITHOLOGIC LOG	FROM	TO	PLUGGING INTERVALS
0	30	Sand			
30	87	Shale			
87	90	Sandstone			
90	102	Shale			
102	113	Sandstone			

7 CONTRACTOR'S OR LANDOWNER'S CERTIFICATION: This water well was (1) constructed, (2) reconstructed, or (3) plugged under my jurisdiction and was completed on (mo/day/year) 5/4/98 and this record is true to the best of my knowledge and belief. Kansas Water Well Contractor's License No. 549 This Water Well Record was completed on (mo/day/yr) 6/3/98 under the business name of J & R Drilling Services, Inc. by (signature) Ray Coon

INSTRUCTIONS: Use typewriter or ball point pen. PLEASE PRESS FIRMLY and PRINT clearly. Please fill in blanks, underline or circle the correct answers. Send top three copies to Kansas Department of Health and Environment, Bureau of Water, Topeka, Kansas 66620-0001. Telephone: 913-296-5545. Send one to WATER WELL OWNER and retain one for your records.

OFFICE USE ONLY T R E W SEC.