


1 LOCATION OF WATER WELL: County: Ellsworth Fraction: SE 1/4 SW 1/4 SW 1/4 Section Number: 30 Township Number: T 15 S Range Number: R 7 ~~6~~ 7

Distance and direction from nearest town or city street address of well if located within city?  
Acme Brick 1915 Avenue L, Kanopolis, KS 67454

2 WATER WELL OWNER: Acme Brick  
 RR#, St. Address, Box #: 1915 Avenue L Board of Agriculture, Division of Water Resources  
 City, State, ZIP Code: Kanopolis, KS 67454 Application Number:

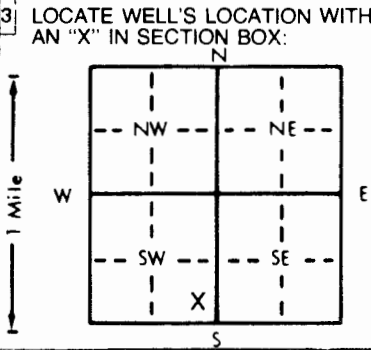

4 DEPTH OF COMPLETED WELL: 116 ft. ELEVATION:  
 Depth(s) Groundwater Encountered: 1. 20 ft. 2. 55 ft. 3. 100 ft.  
 WELL'S STATIC WATER LEVEL:          ft. below land surface measured on mo/day/yr  
 Pump test data: Well water was          ft. after          hours pumping          gpm  
 Est. Yield          gpm: Well water was          ft. after          hours pumping          gpm  
 Bore Hole Diameter: 6 in. to 116 ft. and          in. to          ft.  
 WELL WATER TO BE USED AS:  
 5 Public water supply 8 Air conditioning 11 Injection well  
 1 Domestic 3 Feedlot 6 Oil field water supply 9 Dewatering 12 Other (Specify below)  
 2 Irrigation 4 Industrial 7 Lawn and garden only 10 Monitoring well MW 40  
 Was a chemical/bacteriological sample submitted to Department? Yes          No X; If yes, mo/day/yr sample was submitted  
 Water Well Disinfected? Yes          No X

5 TYPE OF BLANK CASING USED:  
 1 Steel 3 RMP (SR) 5 Wrought iron 8 Concrete tile CASING JOINTS: Glued          Clamped           
 2 PVC 4 ABS 6 Asbestos-Cement 9 Other (specify below) Welded           
 7 Fiberglass Threaded X  
 Blank casing diameter: 2 in. to 100 ft. Dia          in. to          ft. Dia          in. to          ft.  
 Casing height above land surface: -5 in., weight 20 lbs./ft. Wall thickness or gauge No. Sch 40  
 TYPE OF SCREEN OR PERFORATION MATERIAL:  
 1 Steel 3 Stainless steel 5 Fiberglass 8 RMP (SR) 10 Asbestos-cement 11 Other (specify)           
 2 Brass 4 Galvanized steel 6 Concrete tile 9 ABS 12 None used (open hole)  
 SCREEN OR PERFORATION OPENINGS ARE:  
 1 Continuous slot 3 Mill slot 5 Gauzed wrapped 8 Saw cut 11 None (open hole)  
 2 Louvered shutter 4 Key punched 6 Wire wrapped 9 Drilled holes  
 7 Torch cut 10 Other (specify)           
 SCREEN-PERFORATED INTERVALS: From 100 ft. to 115 ft., From          ft. to          ft.  
 From          ft. to          ft., From          ft. to          ft.  
 GRAVEL PACK INTERVALS: From 97 ft. to 116 ft., From          ft. to          ft.  
 From          ft. to          ft., From          ft. to          ft.

6 GROUT MATERIAL: 1 Neat cement 2 Cement grout 3 Bentonite 4 Other Concrete  
 Grout intervals: From 2 ft. to 97 ft., From 0 ft. to 2 ft., From          ft. to          ft.  
 What is the nearest source of possible contamination:  
 1 Septic tank 4 Lateral lines 7 Pit privy 10 Livestock pens 14 Abandoned water well  
 2 Sewer lines 5 Cess pool 8 Sewage lagoon 11 Fuel storage 15 Oil well/Gas well  
 3 Watertight sewer lines 6 Seepage pit 9 Feedyard 12 Fertilizer storage 16 Other (specify below) Salt mine  
 13 Insecticide storage

Direction from well? 800-1000 How many feet?

FROM	TO	LITHOLOGIC LOG	FROM	TO	PLUGGING INTERVALS
0	2	Sandy gravel, brown red, poorly sorted			
2	4	Silty clay, red brown, low plastic			
4	25	Sand, brownish-yellow, coarse			
25	55	Shale, blue-grey, weathered			
55	60	Sandstone, tan, fine grained			
60	100	Shale, blue-grey, weathered			
100	112	Sandstone, tan, fine grained			
112	116	Shale, blue-grey, weathered			

7 CONTRACTOR'S OR LANDOWNER'S CERTIFICATION: This water well was (1) constructed, (2) reconstructed, or (3) plugged under my jurisdiction and was completed on (mo/day/year) 6/3/97 and this record is true to the best of my knowledge and belief. Kansas Water Well Contractor's License No. 549 This Water Well Record was completed on (mo/day/year) 6/5/97 under the business name of J & R Drilling Services, Inc. by (signature) Ray Combs

INSTRUCTIONS: Use typewriter or ball point pen PLEASE PRESS FIRMLY and PRINT clearly. Please fill in blanks, underline or circle the correct answer. Send top three copies to Kansas Department of Health and Environment, Bureau of Water, Topeka, Kansas 66620-0001. Telephone: 913-296-5545. Send one to WATER WELL OWNER and retain one for your records.

OFFICE USE ONLY T R EW SEC 1/4 1/4 1/4