


Well 10

WATER WELL PLUGGING RECORD Form WWC-5P KSA 82a-1212 ID NO.

1 LOCATION OF WATER WELL: Fraction 1/4 nw 1/4 NE 1/4 SW 1/4 Section Number 32 Township Number T 15 S Range Number 7 [] E [x] W

Street/Rural Address of Well Location; if unknown, distance & direction from nearest town or intersection: If at owner's address, check here [] 1 1/4 East of Kanopolis Global Positioning Systems (GPS) information: Latitude: 38.703045 Longitude: 98.126538

2 WATER WELL OWNER: U.S. Army Corps of Engineers RR#, St. Address, Box #: 4860 Outlet Blvd City, State ZIP Code: Sylvan Grove, KS 67481

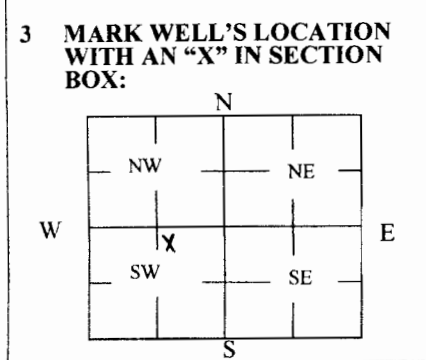

3 MARK WELL'S LOCATION WITH AN "X" IN SECTION BOX: 4 DEPTH OF WELL 9 ft. WELL'S STATIC WATER LEVEL N/A ft. WELL WAS USED AS: [] Domestic [] Irrigation [] Feedlot [] Industrial [] Public Water Supply [] Oil Field Water Supply [] Domestic (Lawn & Garden) [] Air Conditioning [] Dewatering [] Monitoring [] Injection Well [x] Other Windmill

5 TYPE OF BLANK CASING USED: [] Steel [] PVC [] RMP (SR) [] ABS [] Wrought [] Asbestos-Cement [] Fiberglass [] Concrete Tile [x] Other (Specify below) Rock lined

6 GROUT PLUG MATERIAL: [x] Neat cement [] Cement grout [] Bentonite [] Other Grout Plug Intervals: From 9 ft. to 0 ft., From ___ ft. to ___ ft., From ___ ft. to ___ ft.

What is the nearest source of possible contamination: [] Septic tank [] Sewer lines [] Watertight sewer lines [] Lateral lines [] Cess pool [] Seepage pit [] Pit privy [] Sewage lagoon [] Feedyard [] Livestock pens [] Fuel storage [] Fertilizer storage [] Insecticide storage [] Abandoned water well [] Oil well/Gas well [x] Other (specify below) None

Table with 6 columns: FROM, TO, PLUGGING MATERIALS, FROM, TO, PLUGGING MATERIALS. Row 1: 9, 0, Cement, empty, empty, empty.

7 CONTRACTOR'S OR LANDOWNER'S CERTIFICATION: This water well was plugged under my jurisdiction and was completed on (mo/day/year) 4-4-18 and this record is true to the best of my knowledge and belief. Kansas Water Well Contractor's License No. 134. This Water Well Record was completed on (mo/day/year) 4-12-18 under the business name of Rosencrantz- Bemis Ent Inc by (signature) Sara Adefa

Send one white copy to Kansas Department of Health & Environment, Geology Section, 1000 SW Jackson Street, Ste. 420, Topeka, KS 66612-1367. Send one copy to WATER WELL OWNER and retain one for your records. Visit us at http://www.kdheks.gov/waterwell/index.html Telephone 785-296-5524.