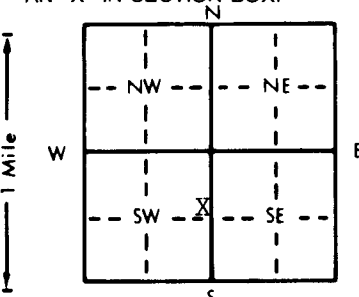


1 LOCATION OF WATER WELL: County: Ellsworth	Fraction SE 1/4 NE 1/4 SW 1/4	Section Number 21	Township Number T 15 S	Range Number R 8W EW
--	----------------------------------	----------------------	---------------------------	-------------------------

Distance and direction from nearest town or city street address of well if located within city?  
in Ellsworth, Kansas

2 WATER WELL OWNER: Mike Brooks  
 RR#, St. Address, Box # : 606 Webb  
 City, State, ZIP Code : Ellsworth, Kansas 67439  
 Board of Agriculture, Division of Water Resources  
 Application Number:

3 LOCATE WELL'S LOCATION WITH AN "X" IN SECTION BOX:  

 4 DEPTH OF COMPLETED WELL: 125 ft. ELEVATION: Unknown  
 Depth(s) Groundwater Encountered 1. 80 ft. 2. ft. 3. ft.  
 WELL'S STATIC WATER LEVEL 80 ft. below land surface measured on mo/day/yr 6/10/95  
 Pump test data: Well water was ft. after hours pumping gpm  
 Est. Yield 20 gpm: Well water was ft. after hours pumping gpm  
 Bore Hole Diameter 7 7/8 in. to 125 ft., and in. to ft.  
 WELL WATER TO BE USED AS:  
 1 Domestic 3 Feedlot 6 Oil field water supply 9 Dewatering 12 Other (Specify below)  
 2 Irrigation 4 Industrial 7 Lawn and garden only 10 Monitoring well  
 Was a chemical/bacteriological sample submitted to Department? Yes No; If yes, mo/day/yr sample was submitted  
 Water Well Disinfected? Yes No

5 TYPE OF BLANK CASING USED:  
 1 Steel 3 RMP (SR) 5 Wrought iron 8 Concrete tile CASING JOINTS: Glued Clamped  
 2 PVC 4 ABS 6 Asbestos-Cement 9 Other (specify below) Welded  
 7 Fiberglass Threaded  
 Blank casing diameter 5 in. to 85 ft., Dia in. to ft., Dia in. to ft.  
 Casing height above land surface 12 in., weight 2.8 lbs./ft. Wall thickness or gauge No. Sch. 40  
 TYPE OF SCREEN OR PERFORATION MATERIAL:  
 1 Steel 3 Stainless steel 5 Fiberglass 7 PVC 8 RMP (SR) 10 Asbestos-cement 11 Other (specify)  
 2 Brass 4 Galvanized steel 6 Concrete tile 9 ABS 12 None used (open hole)  
 SCREEN OR PERFORATION OPENINGS ARE:  
 1 Continuous slot 3 Mill slot 5 Gauzed wrapped 8 Saw cut 11 None (open hole)  
 2 Louvered shutter 4 Key punched 6 Wire wrapped 9 Drilled holes  
 7 Torch cut 10 Other (specify)  
 SCREEN-PERFORATED INTERVALS: From 85 ft. to 125 ft., From ft. to ft.  
 GRAVEL PACK INTERVALS: From 20 ft. to 125 ft., From ft. to ft.

6 GROUT MATERIAL: 1 Neat cement 2 Cement grout 3 Bentonite 4 Other  
 Grout Intervals: From 0 ft. to 20 ft., From ft. to ft.  
 What is the nearest source of possible contamination:  
 1 Septic tank 4 Lateral lines 7 Pit privy 10 Livestock pens 14 Abandoned water well  
 2 Sewer lines 5 Cess pool 8 Sewage lagoon 11 Fuel storage 15 Oil well/Gas well  
 3 Watertight sewer lines 6 Seepage pit 9 Feedyard 12 Fertilizer storage 16 Other (specify below)  
 13 Insecticide storage  
 Direction from well? North How many feet? 30

FROM	TO	LITHOLOGIC LOG	FROM	TO	PLUGGING INTERVALS
0	21	Top soil and clay			
21	35	Sand and gravel			
35	50	Shale			
50	125	Sand rock streaks			

7 CONTRACTOR'S OR LANDOWNER'S CERTIFICATION: This water well was (1) constructed, (2) reconstructed, or (3) plugged under my jurisdiction and was completed on (mo/day/year) 6/10/95 and this record is true to the best of my knowledge and belief. Kansas Water Well Contractor's License No. 186 This Water Well Record was completed on (mo/day/yr) 6/19/95 under the business name of Kelly's Water Well Service, Inc. by (signature) Steve Good

OFFICE USE ONLY  
T  
R  
EW  
SEC.