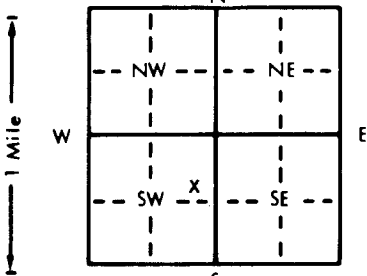


1 LOCATION OF WATER WELL: Fraction SE 1/4 NE 1/4 SW 1/4 Section Number 20 Township Number T 15 S Range Number R 8 E/W
 County: Ellsworth

Distance and direction from nearest town or city street address of well if located within city?
 100 ft South of SE corner of Central Kansa Mill and Elevator, S. Colorado, Ellsworth, KS MW-3 HWST Job NO. 74-51/5002.0

2 WATER WELL OWNER: Central Kansas Mill and Elevator
 RR#, St. Address, Box #: South Colorado Street Board of Agriculture, Division of Water Resources
 City, State, ZIP Code: Ellsworth, Kansas 67439 Application Number:

3 LOCATE WELL'S LOCATION WITH AN "X" IN SECTION BOX:

 4 DEPTH OF COMPLETED WELL: 31 ft. ELEVATION: N/A
 Depth(s) Groundwater Encountered 1. 27 ft. 2. ft. 3. ft.
 WELL'S STATIC WATER LEVEL 25.87 ft. below land surface measured on mo/day/yr 4/26/91
 Pump test data: Well water was ft. after hours pumping gpm
 Est. Yield gpm: Well water was ft. after hours pumping gpm
 Bore Hole Diameter 6.5 in. to 31 ft., and in. to ft.
 WELL WATER TO BE USED AS: 5 Public water supply 8 Air conditioning 11 Injection well
 1 Domestic 3 Feedlot 6 Oil field water supply 9 Dewatering 12 Other (Specify below)
 2 Irrigation 4 Industrial 7 Lawn and garden only 10 Monitoring well
 Was a chemical/bacteriological sample submitted to Department? Yes No x; If yes, mo/day/yr sample was submitted
 Water Well Disinfected? Yes No x

5 TYPE OF BLANK CASING USED: 5 Wrought iron 8 Concrete tile CASING JOINTS: Glued Clamped
 1 Steel 3 RMP (SR) 6 Asbestos-Cement 9 Other (specify below) Welded
 PVC 4 ABS 7 Fiberglass Threaded x
 Blank casing diameter 2 in. to 21 ft., Dia in. to ft., Dia in. to ft.
 Casing height above land surface Flush in., weight lbs./ft. Wall thickness or gauge No. sch 40
 TYPE OF SCREEN OR PERFORATION MATERIAL: x PVC 10 Asbestos-cement
 1 Steel 3 Stainless steel 5 Fiberglass 8 RMP (SR) 11 Other (specify)
 2 Brass 4 Galvanized steel 6 Concrete tile 9 ABS 12 None used (open hole)
 SCREEN OR PERFORATION OPENINGS ARE: 5 Gauzed wrapped 8 Saw cut 11 None (open hole)
 1 Continuous slot x Mill slot 6 Wire wrapped 9 Drilled holes
 2 Louvered shutter 4 Key punched 7 Torch cut 10 Other (specify)
 SCREEN-PERFORATED INTERVALS: From 21 ft. to 31 ft., From ft. to ft.
 From ft. to ft., From ft. to ft.
 GRAVEL PACK INTERVALS: From 19 ft. to 31 ft., From ft. to ft.
 From ft. to ft., From ft. to ft.

6 GROUT MATERIAL: 1 Neat cement 2 Cement grout x Bentonite 4 Other
 Grout Intervals: From 1 ft. to 19 ft., From ft. to ft., From ft. to ft.
 What is the nearest source of possible contamination:
 1 Septic tank 4 Lateral lines 7 Pit privy 10 Livestock pens 14 Abandoned water well
 2 Sewer lines 5 Cess pool 8 Sewage lagoon x Fuel storage 15 Oil well/Gas well
 3 Watertight sewer lines 6 Seepage pit 9 Feedyard 12 Fertilizer storage 16 Other (specify below)
 13 Insecticide storage
 Direction from well? North How many feet? 240

FROM	TO	LITHOLOGIC LOG	FROM	TO	PLUGGING INTERVALS
0	11.5	Silty clay			
11.5	27.0	silty sand			
27.0	29.0	sand			
29.0	31.0	Gravelly sand			

7 CONTRACTOR'S OR LANDOWNER'S CERTIFICATION: This water well was (1) constructed, (2) reconstructed, or (3) plugged under my jurisdiction and was completed on (mo/day/year) 4/16/91 and this record is true to the best of my knowledge and belief. Kansas Water Well Contractor's License No. 471-A. This Water Well Record was completed on (mo/day/yr) 4/26/91 under the business name of HWS Technologies Inc. by (signature) [Signature]

INSTRUCTIONS: Use typewriter or ball point pen. PLEASE PRESS FIRMLY and PRINT clearly. Please fill in blanks, underline or circle the correct answers. Send top three copies to Kansas Department of Health and Environment, Bureau of Water, Topeka, Kansas 66620-7320. Telephone: 913-296-5545. Send one to WATER WELL OWNER and retain one for your records.

OFFICE USE ONLY
T
R
E/W
SEC.