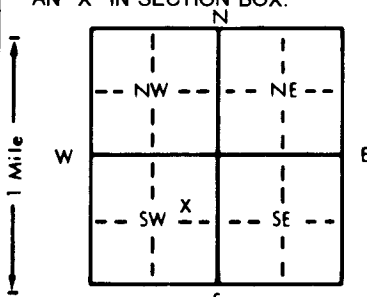


1 LOCATION OF WATER WELL: Fraction SE 1/4 NE 1/4 SW 1/4 Section Number 20 Township Number T 15 S Range Number R 8 E/W

Distance and direction from nearest town or city street address of well if located within city?
 105 feet west of SE corner of Central Kansas Mill & Elevator, S. Colorado, Ellsworth MW-5 HWST Job No. 51/5002.01

2 WATER WELL OWNER: Central Kansas Mill & Elevator
 RR#, St. Address, Box #: South Colorado Street Board of Agriculture, Division of Water Resources
 City, State, ZIP Code: Ellsworth, Kansas 67439 Application Number:

3 LOCATE WELL'S LOCATION WITH AN "X" IN SECTION BOX:

 4 DEPTH OF COMPLETED WELL: 31.5 ft. ELEVATION: N/A
 Depth(s) Groundwater Encountered 1. 27 ft. 2. ft. 3. ft.
 WELL'S STATIC WATER LEVEL: 25.92 ft. below land surface measured on mo/day/yr 4/26/91
 Pump test data: Well water was ft. after hours pumping gpm
 Est. Yield gpm: Well water was ft. after hours pumping gpm
 Bore Hole Diameter: 6.5 in. to 31.5 ft., and in. to ft.
 WELL WATER TO BE USED AS:
 5 Public water supply 8 Air conditioning 11 Injection well
 1 Domestic 3 Feedlot 6 Oil field water supply 9 Dewatering 12 Other (Specify below)
 2 Irrigation 4 Industrial 7 Lawn and garden only 10 Monitoring well
 Was a chemical/bacteriological sample submitted to Department? Yes No X; If yes, mo/day/yr sample was submitted
 Water Well Disinfected? Yes No X

5 TYPE OF BLANK CASING USED:
 1 Steel 3 RMP (SR) 5 Wrought iron 8 Concrete tile CASING JOINTS: Glued Clamped
 2 PVC 4 ABS 6 Asbestos-Cement 9 Other (specify below) Welded
 7 Fiberglass Threaded X
 Blank casing diameter 2 in. to 21.5 ft., Dia. in. to ft., Dia. in. to ft.
 Casing height above land surface: Flush in., weight lbs./ft. Wall thickness or gauge No. Sch. 40
 TYPE OF SCREEN OR PERFORATION MATERIAL:
 1 Steel 3 Stainless steel 5 Fiberglass 8 RMP (SR) 10 Asbestos-cement
 2 Brass 4 Galvanized steel 6 Concrete tile 9 ABS 11 Other (specify)
 12 None used (open hole)
 SCREEN OR PERFORATION OPENINGS ARE:
 1 Continuous slot 2 Mill slot 5 Gauzed wrapped 8 Saw cut 11 None (open hole)
 2 Louvered shutter 4 Key punched 6 Wire wrapped 9 Drilled holes
 7 Torch cut 10 Other (specify)
 SCREEN-PERFORATED INTERVALS: From 21.5 ft. to 31.5 ft., From ft. to ft.
 GRAVEL PACK INTERVALS: From 19.5 ft. to 31.5 ft., From ft. to ft.

6 GROUT MATERIAL: 1 Neat cement 2 Cement grout 3 Bentonite 4 Other
 Grout Intervals: From 1 ft. to 19.5 ft., From ft. to ft., From ft. to ft.
 What is the nearest source of possible contamination:
 1 Septic tank 4 Lateral lines 7 Pit privy 10 Livestock pens 14 Abandoned water well
 2 Sewer lines 5 Cess pool 8 Sewage lagoon 11 Fuel storage 15 Oil well/Gas well
 3 Watertight sewer lines 6 Seepage pit 9 Feedyard 12 Fertilizer storage 16 Other (specify below)
 13 Insecticide storage
 Direction from well? North How many feet? 140

FROM	TO	LITHOLOGIC LOG	FROM	TO	PLUGGING INTERVALS
0	1.5	Clayey sand			
1.5	7.5	Silty clay			
7.5	12.5	Silty sand			
12.5	13.0	Sand			
13.0	18.5	Silty clay			
18.5	23.5	Silty sand			
23.5	27.0	Sand			
27.0	31.5	Gravelly sand			

7 CONTRACTOR'S OR LANDOWNER'S CERTIFICATION: This water well was (X) constructed, (2) reconstructed, or (3) plugged under my jurisdiction and was completed on (mo/day/year) 4/17/91 and this record is true to the best of my knowledge and belief. Kansas Water Well Contractor's License No. 471-A This Water Well Record was completed on (mo/day/yr) 4/26/91 under the business name of HWS Technologies Inc. by (signature) *Shawn Maloney*

OFFICE USE ONLY
T
R
E/W
SEC.
1/4
1/4
1/4