


1 LOCATION OF WATER WELL: County: Ellsworth Fraction 1/4 SE 1/4 NE 1/4 Section Number 25 Township Number T 15 S Range Number R 8 E

Distance and direction from nearest town or city street address of well if located within city? Kanopolis, Mo. Leopoldis Red 709 1/2 mile North of Kanopolis, Mo. on Leitchway

2 WATER WELL OWNER: WILLIAMS NATURAL GAS CO. RR#, St. Address, Box #: RR #1, Box 162 City, State, ZIP Code: Lyons, KS 67554 Board of Agriculture, Division of Water Resources Application Number:

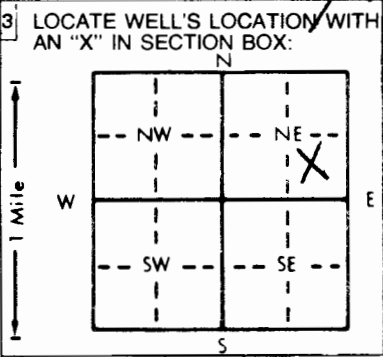

3 LOCATE WELL'S LOCATION WITH AN 'X' IN SECTION BOX: 4 DEPTH OF COMPLETED WELL: 300' ft. ELEVATION: Depth(s) Groundwater Encountered: 1. ft. 2. ft. 3. ft. WELL'S STATIC WATER LEVEL: 75 ft. below land surface measured on mo/day/yr Pump test data: Well water was ... ft. after ... hours pumping ... gpm Est. Yield: N/A gpm Well water was ... ft. after ... hours pumping ... gpm Bore Hole Diameter: 8" in. to 300' ft. and ... in. to ... ft. WELL WATER TO BE USED AS: 5 Public water supply 3 Air conditioning 11 Injection well 1 Domestic 3 Feedlot 6 Oil field water supply 9 Dewatering 2 Irrigation 4 Industrial 7 Lawn and garden only 10 Monitoring well Other (Specify below) Cathedral Retreat Was a chemical/bacteriological sample submitted to Department? Yes No; If yes, mo/day/yr sample was submitted Water Well Disinfected? Yes No

5 TYPE OF BLANK CASING USED: 1 Steel 2 PVC 3 RMP (SR) 4 ABS 5 Wrought iron 6 Asbestos-Cement 7 Fiberglass 8 Concrete tile 9 Other (specify below) CASING JOINTS: Glued Clamped Welded Threaded Blank casing diameter: 6" in. to 120' ft. Dia. Casing height above land surface: 2' in. weight: 52.40 lbs./ft. Wall thickness or gauge No. TYPE OF SCREEN OR PERFORATION MATERIAL: 1 Steel 2 Brass 3 Stainless steel 4 Galvanized steel 5 Fiberglass 6 Concrete tile 7 PVC 8 RMP (SR) 9 ABS 10 Asbestos-cement 11 Other (specify) 12 None used (open hole) SCREEN OR PERFORATION OPENINGS ARE: 1 Continuous slot 2 Louvered shutter 3 Mill slot 4 Key punched 5 Gauzed wrapped 6 Wire wrapped 7 Torch cut 8 Saw cut 9 Drilled holes 10 Other (specify) 11 None (open hole) SCREEN-PERFORATED INTERVALS: From NA ft. to ft. From ft. to ft. GRAVEL PACK INTERVALS: From NA ft. to ft. From ft. to ft.

6 GROUT MATERIAL: 1 Neat cement 2 Cement grout 3 Bentonite 4 Other: Lake Breeze Grout Intervals: From 0 ft. to 20' ft. From 100' ft. to 300' ft. What is the nearest source of possible contamination: 1 Septic tank 2 Sewer lines 3 Watertight sewer lines 4 Lateral lines 5 Cess pool 6 Seepage pit 7 Pit privy 8 Sewage lagoon 9 Feedyard 10 Livestock pens 11 Fuel storage 12 Fertilizer storage 13 Insecticide storage 14 Abandoned water well 15 Oil well/Gas well 16 Other (specify below) None close

FROM	TO	LITHOLOGIC LOG	FROM	TO	PLUGGING INTERVALS
0	75	CLAY			
75	90	SAND			
90	140	CLAY			
140	215	Shale			
215	220	Rock			
220	300	Shale / Clay Strata			

7 CONTRACTOR'S OR LANDOWNER'S CERTIFICATION: This water well was (1) constructed, (2) reconstructed, or (3) plugged under my jurisdiction and was completed on (mo/day/year) 4-7-90 and this record is true to the best of my knowledge and belief. Kansas Water Well Contractor's License No. This Water Well Record was completed on (mo/day/yr) 4-2-90 SKTA under the business name of Rick Young Water Well Service by (signature) Rick Young