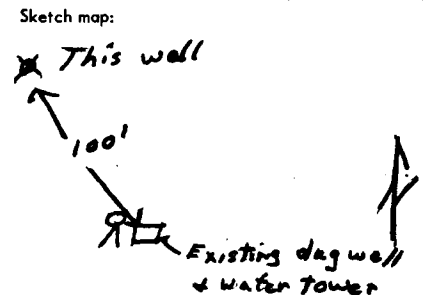


USE TYPEWRITER OR BALL POINT PEN-PRESS FIRMLY, PRINT CLEARLY.

WATER WELL RECORD
KSA 82a-1201-1215

Kansas Department of Health and Environment-Division of Environment (Water well Contractors) Topeka, Kansas 66620


1. Location of well:		County Ellsworth	Fraction SE 1/4 SE 1/4 SW 1/4	Section number 29	Township number T 15 S R	Range number 8	E.W.
2. Distance and direction from nearest town or city: Street address of well location if in city: 1/2 Mi. W Ellsworth				3. Owner of well: Good Samaritan Home R. or street: Rt 1 City, state, zip code: Ellsworth, Kans 67439			
4. Locate with "X" in section below: N W E S 1 Mile		Sketch map: 		6. Bore hole dia. 6 in. Completion date 3-19-76 Well depth 40 ft.			
5. Type and color of material		Terrace:		7. Cable tool <input checked="" type="checkbox"/> Rotary <input type="checkbox"/> Driven <input type="checkbox"/> Dug <input type="checkbox"/> Hollow rod <input type="checkbox"/> Jetted <input type="checkbox"/> Bored <input type="checkbox"/> Reverse rotary			
		Clay, silty, compact, olive		8. Use: <input type="checkbox"/> Domestic <input checked="" type="checkbox"/> Public supply <input type="checkbox"/> Industry <input type="checkbox"/> Irrigation <input type="checkbox"/> Air conditioning <input type="checkbox"/> Stock <input type="checkbox"/> Lawn <input type="checkbox"/> Oil field water <input type="checkbox"/> Other			
		Gravel, medium to fine sand		9. Casing: Material PVC Height Above below Threaded <input type="checkbox"/> Welded <input type="checkbox"/> Surface 12 in. RMP <input type="checkbox"/> PVC <input type="checkbox"/> Weight <input type="checkbox"/> lbs./ft. Dia. 4 in. to 40 ft. depth Wall Thickness: inches or Dia. <input type="checkbox"/> in. to <input type="checkbox"/> ft. depth gage No. 0.237			
		Dakota fm (?)		10. Screen: Manufacturer's name shop Type pvc slots Dia. 4 1/2 Slot/gauze 3/32 Length 5' Set between 35 ft. and 40 ft. ft. and <input type="checkbox"/> ft. Gravel pack? <input checked="" type="checkbox"/> Size range of material 3/8"			
		Shale, light gray, mottled red		11. Static water level: <input type="checkbox"/> mo./day/yr. 29.2 ft. below land surface Date 3-19-76			
				12. Pumping level below land surfaces: 36 ft. after 1 hrs. pumping 5 g.p.m. <input type="checkbox"/> ft. after <input type="checkbox"/> hrs. pumping <input type="checkbox"/> g.p.m. Estimated maximum yield <input type="checkbox"/> g.p.m.			
				13. Water sample submitted: <input type="checkbox"/> mo./day/yr. Yes <input checked="" type="checkbox"/> No Date <input type="checkbox"/>			
				14. Well head completion: <input type="checkbox"/> Pitless adapter 12 Inches above grade			
				15. Well grouted? <input checked="" type="checkbox"/> With: <input checked="" type="checkbox"/> Neat cement <input type="checkbox"/> Bentonite <input type="checkbox"/> Concrete Depth: From 0 ft. to 20 ft.			
				16. Nearest source of possible contamination: ft. 100 Direction SE Type Dug well Well disinfected upon completion? <input checked="" type="checkbox"/> Yes <input type="checkbox"/> No			
				17. Pump: <input checked="" type="checkbox"/> Not installed Manufacturer's name <input type="checkbox"/> Model number <input type="checkbox"/> HP <input type="checkbox"/> Volts <input type="checkbox"/> Length of drop pipe <input type="checkbox"/> ft. capacity <input type="checkbox"/> g.p.m. Type: <input type="checkbox"/> Submersible <input type="checkbox"/> Turbine <input type="checkbox"/> Jet <input type="checkbox"/> Reciprocating <input type="checkbox"/> Centrifugal <input type="checkbox"/> Other			
18. Elevation: Topography: <input type="checkbox"/> Hill <input type="checkbox"/> Slope <input type="checkbox"/> Upland <input checked="" type="checkbox"/> Valley		19. Remarks: Static(?) water level probably low because of well 100' SE pumping		20. Water well contractor's certification: This well was drilled under my jurisdiction and this report is true to the best of my knowledge and belief. Hydramulia Drilling Co 126 Business name License No. Address Salina Kans Signed D. R. Fant Date 5-17-76 Authorized representative			

RECEIVED

DEC 10 1979

DIVISION OF ENVIRONMENT
OF KANSAS

(Use a second sheet if needed)

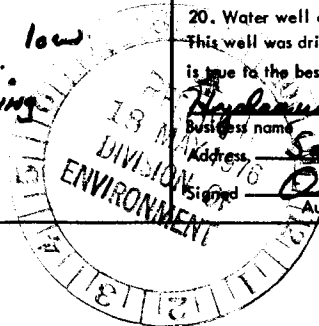

15-8-29 SE SEC 29