


1 LOCATION OF WATER WELL:	Fraction	Section Number	Township Number	Range Number
County: <u>Ellsworth</u>	<u>NE¹/₄ NE¹/₄ NW¹/₄</u>	<u>21</u>	<u>15-5</u>	<u>8-W</u>

Distance and direction from nearest town or city street address of well if located within city?
SW Corner of Jet 140 & US 156 Hwy Ellsworth, Ks MW# 7

2 WATER WELL OWNER: <u>Don Parzer</u>	Board of Agriculture, Division of Water Resources
RR #, St. Address, Box #: <u>411 Bradley St</u>	Application Number:
City, State, ZIP Code: <u>Ellsworth, Ks 67439</u>	

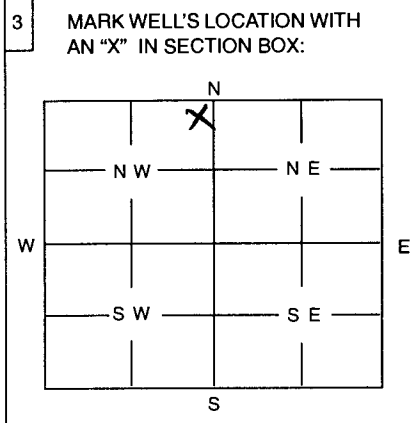

4 DEPTH OF WELL 49 ft

WELL'S STATIC WATER LEVEL ft.

WELL WAS USED AS:

1 Domestic	5 Public Water Supply	9 Dewatering
2 Irrigation	6 Oil Field Water Supply	<input checked="" type="radio"/> 10 Monitoring Well
3 Feedlot	7 Domestic (Lawn & Garden)	11 Injection Well
4 Industrial	8 Air Conditioning	12 Other

Was a chemical / bacteriological sample submitted to Department? Yes No
 If yes, mo/day/yr sample was submitted

Water Well Disinfected: Yes No

5 TYPE OF BLANK CASING USED:

1 Steel	3 RMP (SR)	5 Wrought	7 Fiberglass	9 Other (Specify below)
<input checked="" type="radio"/> PVC	4 ABS	6 Asbestos-Cement	8 Concrete Tile

Blank casing diameter 2 in. Was casing pulled? Yes No If yes, how much 30+ Sec
 Casing height above or below land surface in.

6 GROUT PLUG MATERIAL: 1 Neat cement 2 Cement grout Bentonite Other Topsoil & rock

Grout Plug Intervals: From ft. to ft., From 49 ft. to 1 ft., From 1 to 0 ft.

What is the nearest source of possible contamination:

1 Septic tank	6 Seepage pit	11 Fuel storage	16 Other (specify below)
2 Sewer lines	7 Pit privy	12 Fertilizer storage
<input checked="" type="radio"/> 3 Watertight sewer lines	8 Sewage lagoon	13 Insecticide storage
4 Lateral lines	9 Feedyard	14 Abandoned water well
5 Cess Pool	10 Livestock pens	15 Oil well/Gas well

Direction from well? South West How many feet? 270

FROM	TO	PLUGGING MATERIALS
<u>49</u>	<u>1</u>	<u>Bentonite 3/8 chips</u>
<u>1</u>	<u>0</u>	<u>Topsoil & rock gravel</u>

7 CONTRACTOR'S OR LANDOWNER'S CERTIFICATION: This water well was plugged under my jurisdiction and was completed on (mo/day/year) 6-29-01 and this record is true to the best of my knowledge and belief. Kansas Water Well Contractor's License No. 575 This Water Well Record was completed on (mo/day/year) 7-12-01 under the business name of FUNKEE DILLING SERVICE INC by (signature) [Signature]

INSTRUCTIONS: Use typewriter or ball point pen. Please press firmly and print clearly. Please fill in blanks, underline or circle the correct answers. Send top three copies to Kansas Department of Health and Environment, Bureau of Water, Topeka, Kansas 66620-0001. Telephone: 785/296-3565. Send one to Water Well Owner and retain one for your records.