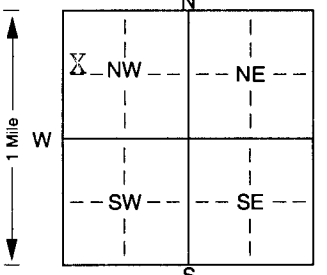


1 LOCATION OF WATER WELL: County: <u>Ellsworth</u>	Fraction <u>SW 1/4 NW 1/4 NW 1/4</u>	Section Number <u>20</u>	Township Number <u>T 15 S</u>	Range Number <u>R 8 E/W</u>
---	---	-----------------------------	----------------------------------	--------------------------------

Distance and direction from nearest town or city street address of well if located within city?
515 W. 9th city of Ellsworth, Ks.

2 WATER WELL OWNER: Alex Falk
 RR#, St. Address, Box # : 515 W. 9th
 City, State, ZIP Code : Ellsworth, Ks. 67439
 Board of Agriculture, Division of Water Resources
 Application Number:

3 LOCATE WELL'S LOCATION WITH AN "X" IN SECTION BOX: 	4 DEPTH OF COMPLETED WELL: <u>58</u> ft. ELEVATION: Depth(s) Groundwater Encountered 1. ft. 2. ft. 3. ft. WELL'S STATIC WATER LEVEL <u>41</u> ft. below land surface measured on mo/day/yr <u>8-13-02</u> Pump test data: Well water was ft. after hours pumping gpm Est. Yield <u>NA</u> gpm; Well water was ft. after hours pumping gpm Bore Hole Diameter: <u>9.7/8</u> in. to <u>68</u> ft., and in. to ft. WELL WATER TO BE USED AS: 5 Public water supply 8 Air conditioning 11 Injection well 1 Domestic 3 Feedlot 6 Oil field water supply 9 Dewatering 12 Other (Specify below) 2 Irrigation 4 Industrial 7 <u>Domestic (lawn & garden)</u> 10 Monitoring well Was a chemical/bacteriological sample submitted to Department? Yes. No. <u>X</u> ; If yes, mo/day/yr sample was submitted Water Well Disinfected? Yes <u>HTH</u> No
--	--

5 TYPE OF BLANK CASING USED:
 1 Steel 3 RMP (SR) 5 Wrought iron 8 Concrete tile CASING JOINTS: Glued. Clamped.
 2 PVC 4 ABS 6 Asbestos-Cement 9 Other (specify below) Welded
 7 Fiberglass Threaded.
 Blank casing diameter . . . 5 in. to 48 ft., Dia . . . 5 in. to 68-48 ft., Dia in. to ft.
 Casing height above land surface. . . 24 in., weight . . . SDR-26 lbs./ft. Wall thickness or gauge No.
 TYPE OF SCREEN OR PERFORATION MATERIAL:
 1 Steel 3 Stainless steel 5 Fiberglass 7 PVC 10 Asbestos-cement
 2 Brass 4 Galvanized steel 6 Concrete tile 8 RMP (SR) 11 Other (specify)
 12 None used (open hole)
 SCREEN OR PERFORATION OPENINGS ARE:
 1 Continuous slot 3 Mill slot 5 Gauzed wrapped 8 Saw cut 11 None (open hole)
 2 Louvered shutter 4 Key punched 6 Wire wrapped 9 Drilled holes
 7 Torch cut 10 Other (specify) ft.
 SCREEN-PERFORATED INTERVALS: From . . 58 ft. to 48 ft., From ft. to ft.
 From ft. to ft., From ft. to ft.
 GRAVEL PACK INTERVALS: From . . 68 ft. to 20 ft., From ft. to ft.
 From ft. to ft., From ft. to ft.

6 GROUT MATERIAL: 1 Neat cement 2 Cement grout 3 Bentonite 4 Other hole plug
 Grout Intervals: From 20 ft. to 0 ft., From ft. to ft., From ft. to ft.
 What is the nearest source of possible contamination:
 1 Septic tank 4 Lateral lines 7 Pit privy 10 Livestock pens 14 Abandoned water well
 2 Sewer lines 5 Cess pool 8 Sewage lagoon 11 Fuel storage 15 Oil well/Gas well
 3 Watertight sewer lines 6 Seepage pit 9 Feedyard 12 Fertilizer storage 16 Other (specify below)
 . . . House
 Direction from well? South How many feet? 20

FROM	TO	LITHOLOGIC LOG	FROM	TO	PLUGGING INTERVALS
0	3	top soil			
3	5	sand and gravel			
5	29	fire clay			
29	36	gray shale			
36	47	sand stone			
47	59	gray shale, sand stone, and coal			
59	68	Fire clay			

7 CONTRACTOR'S OR LANDOWNER'S CERTIFICATION: This water well was (1) constructed, (2) reconstructed, or (3) plugged under my jurisdiction and was completed on (mo/day/year) . . 8-13-02 and this record is true to the best of my knowledge and belief. Kansas Water Well Contractor's Licence No. . . 134 This Water Well Record was completed on (mo/day/yr) . . 8-19-02 under the business name of Rosencrantz- Bemis by (signature) Fredia Redson