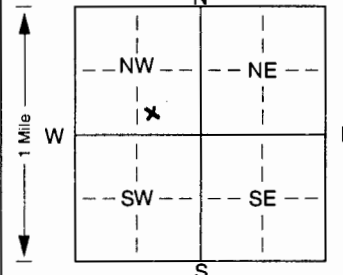


1 LOCATION OF WATER WELL: County: <u>Ellsworth</u> Fraction <u>SW 1/4 SE 1/4 NW 1/4</u> Section Number <u>20</u> Township Number <u>T 15 S</u> Range Number <u>R 8 EW</u>
--

Distance and direction from nearest town or city street address of well if located within city? Gay and Ninth Street, Ellsworth, Ks.

2 WATER WELL OWNER: <u>City of Ellsworth</u> RR#, St. Address, Box #: <u>121 W 1st</u> City, State, ZIP Code: <u>Ellsworth, Ks 67439</u>	Board of Agriculture, Division of Water Resources Application Number: <u>20020043</u>
--	--

3 LOCATE WELL'S LOCATION WITH AN "X" IN SECTION BOX: 	4 DEPTH OF COMPLETED WELL: <u>30</u> ft. ELEVATION: Depth(s) Groundwater Encountered 1. <u>18</u> ft. 2. <u>30</u> ft. 3. <u>0.3114102</u> ft. WELL'S STATIC WATER LEVEL <u>18</u> ft. below land surface measured on mo/day/yr <u>0.3114102</u> Pump test data: Well water was _____ ft. after _____ hours pumping _____ gpm Est. Yield _____ gpm: Well water was _____ ft. after _____ hours pumping _____ gpm Bore Hole Diameter: <u>9</u> in. to <u>30</u> ft., and _____ in. to _____ ft. WELL WATER TO BE USED AS: 5 Public water supply 8 Air conditioning 11 Injection well 1 Domestic 3 Feedlot 6 Oil field water supply 9 <u>Dewatering</u> 12 Other (Specify below) 2 Irrigation 4 Industrial 7 Domestic (lawn & garden) 10 Monitoring well Was a chemical/bacteriological sample submitted to Department? Yes _____ No <u>X</u> ; If yes, mo/day/yr sample was sub- mitted Water Well Disinfected? Yes <u>X</u> No
--	--

5 TYPE OF BLANK CASING USED: 1 Steel 3 RMP (SR) 5 Wrought iron 8 Concrete tile CASING JOINTS: <u>Glued</u> _____ Clamped _____ 2 <u>PVC</u> 4 <u>ABS</u> 6 Asbestos-Cement 9 Other (specify below) Welded _____ 7 Fiberglass _____ Threaded _____	Blank casing diameter <u>5</u> in. to <u>15</u> ft., Dia _____ in. to _____ ft., Dia _____ in. to _____ ft. Casing height above land surface: <u>24</u> in., weight <u>160</u> lbs./ft. Wall thickness or gauge No. <u>214</u> TYPE OF SCREEN OR PERFORATION MATERIAL: 7 <u>PVC</u> 10 Asbestos-cement 1 Steel 3 Stainless steel 5 Fiberglass 8 RMP (SR) 11 Other (specify) _____ 2 Brass 4 Galvanized steel 6 Concrete tile 9 ABS 12 None used (open hole) SCREEN OR PERFORATION OPENINGS ARE: 5 Gauzed wrapped 8 <u>Saw cut</u> 11 None (open hole) 1 Continuous slot 3 Mill slot 6 Wire wrapped 9 <u>Drilled holes</u> 2 Louvered shutter 4 Key punched 7 Torch cut 10 Other (specify) _____ ft. SCREEN-PERFORATED INTERVALS: From <u>15</u> ft. to <u>30</u> ft., From _____ ft. to _____ ft. From _____ ft. to _____ ft., From _____ ft. to _____ ft. GRAVEL PACK INTERVALS: From <u>30</u> ft. to <u>10</u> ft., From _____ ft. to _____ ft. From _____ ft. to _____ ft., From _____ ft. to _____ ft.
--	--

6 GROUT MATERIAL: 1 Neat cement 2 Cement grout 3 Bentonite 4 <u>Other: HOLE PLUG</u> Grout Intervals: From <u>10</u> ft. to <u>0</u> ft., From _____ ft. to _____ ft., From _____ ft. to _____ ft. What is the nearest source of possible contamination: 10 Livestock pens 14 Abandoned water well 1 Septic tank 4 Lateral lines 7 Pit privy 11 Fuel storage 15 Oil well/Gas well 2 Sewer lines 5 Cess pool 8 Sewage lagoon 12 Fertilizer storage 16 Other (specify below) 3 Watertight sewer lines 6 Seepage pit 9 Feedyard 13 Insecticide storage <u>NAT'L GAS LINE</u> Direction from well? <u>WEST</u> How many feet? <u>20</u>
---

FROM	TO	LITHOLOGIC LOG	FROM	TO	PLUGGING INTERVALS
0	3	Top Soil			
3	5	Clay			
5	30	Small Sand & Gravel			

7 CONTRACTOR'S OR LANDOWNER'S CERTIFICATION: This water well was (1) <u>constructed</u> , (2) reconstructed, or (3) plugged under my jurisdiction and was completed on (mo/day/year) <u>03/11/02</u> and this record is true to the best of my knowledge and belief. Kansas Water Well Contractor's Licence No. <u>134</u> This Water Well Record was completed on (mo/day/yr) <u>03/29/02</u> under the business name of <u>Rosecrantz Bemis Est.</u> by (signature) <u>Jessica Dodson</u>
---