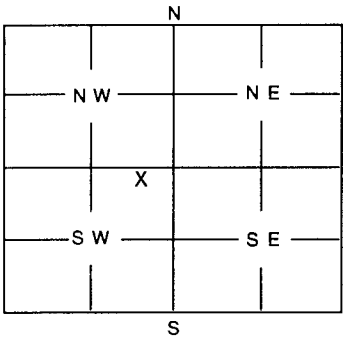


1	LOCATION OF WATER WELL: County: Ellsworth	Fraction NE ¼ NE ¼ SW ¼	Section Number 20	Township Number 15	Range Number 8 <i>W</i>
---	---	-----------------------------------	-----------------------------	------------------------------	-----------------------------------

Distance and direction from nearest town or city street address of well if located within city?
Approximately 50' east from 802 W. 8th Street, city of Ellsworth, KS

2	WATER WELL OWNER: Sam Karst RR #, St. Address, Box #: 1577 Avenue JJ City, State, ZIP Code : Ellsworth, KS 67439	Board of Agriculture, Division of Water Resources Application Number:
---	---	--

3	MARK WELL'S LOCATION WITH AN "X" IN SECTION BOX: 
---	---

4	DEPTH OF WELL 19 ft. WELL'S STATIC WATER LEVEL 11 ft. WELL WAS USED AS: <input checked="" type="checkbox"/> 1 Domestic 5 Public Water Supply 9 Dewatering <input type="checkbox"/> 2 Irrigation 6 Oil Field Water Supply 10 Monitoring Well <input type="checkbox"/> 3 Feedlot 7 Domestic (Lawn & Garden) 11 Injection Well <input type="checkbox"/> 4 Industrial 8 Air Conditioning 12 Other Was a chemical / bacteriological sample submitted to Department? Yes No <input checked="" type="checkbox"/> If yes, mo/day/yr sample was submitted Water Well Disinfected: Yes <input checked="" type="checkbox"/> No
---	--

5	TYPE OF BLANK CASING USED: 1 Steel 3 RMP (SR) 5 Wrought 7 Fiberglass <input checked="" type="checkbox"/> 9 Other (Specify below) Sandstone Rock 2 PVC 4 ABS 6 Asbestos-Cement 8 Concrete Tile Blank casing diameter 7.2 in. Was casing pulled? Yes No <input checked="" type="checkbox"/> If yes, how much Casing height above or below land surface in.
---	---

6	GROUT PLUG MATERIAL: 1 Neat cement 2 Cement grout <input checked="" type="checkbox"/> 3 Bentonite 4 Other Grout Plug Intervals: From ft. to ft., From ft. to ft., From to ft. What is the nearest source of possible contamination: 1 Septic tank 6 Seepage pit 11 Fuel storage 16 Other (specify below) 2 Sewer lines 7 Pit privy 12 Fertilizer storage 3 Watertight sewer lines 8 Sewage lagoon 13 Insecticide storage 4 Lateral lines 9 Feedyard 14 Abandoned water well 5 Cess Pool 10 Livestock pens 15 Oil well/Gas well Direction from well? How many feet?
---	--

FROM	TO	PLUGGING MATERIALS
19	8	Chlorinated Sand
8	5	Subsoil Clays
5	4.5	Bentonite
4.5	0	Topsoil

7	CONTRACTOR'S OR LANDOWNER'S CERTIFICATION: This water well was plugged under my jurisdiction and was completed on (mo/day/year) June 5, 2002 and this record is true to the best of my knowledge and belief. Kansas Water Well Contractor's License No. This Water Well Record was completed on (mo/day/year) June 10, 2002 under the business name of Landowner by (signature) <i>X Sam Karst</i>
---	---

INSTRUCTIONS: Use typewriter or ball point pen. Please press firmly and print clearly. Please fill in blanks, underline or circle the correct answers. Send top three copies to Kansas Department of Health and Environment, Bureau of Water, Topeka, Kansas 66620-0001. Telephone: 785/296-3565. Send one to Water Well Owner and retain one for your records.