


1 LOCATION OF WATER WELL: County: ELLSWORTH	Fraction NW ¼ NW ¼ NE ¼	Section Number 21	Township Number T 15 S	Range Number R 8 E/W
--	----------------------------	----------------------	---------------------------	-------------------------

Distance and direction from nearest town or city street address of well if located within city?  
SOUTHEAST INTERSECT OF HWY 140 & U.S. 156 ELLSWORTH, KS MW#9

2 WATER WELL OWNER: BOB OTT  
RR#, St. Address, Box #: 1315 BEVERLY DRIVE  
City, State, ZIP Code: SALINA, KS 67401  
Board of Agriculture, Division of Water Resources  
Application Number:

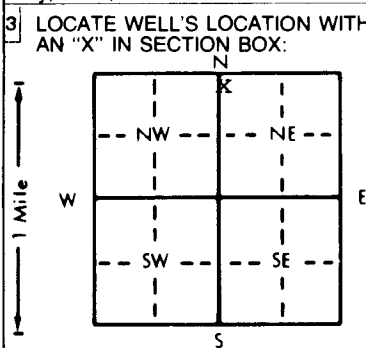

4 DEPTH OF COMPLETED WELL: 40 ft. ELEVATION:  
Depth(s) Groundwater Encountered 1. . . . . ft. 2. . . . . ft. 3. . . . . ft.  
WELL'S STATIC WATER LEVEL . . . . . ft. below land surface measured on mo/day/yr . . . . .  
Pump test data: Well water was . . . . . ft. after . . . . . hours pumping . . . . . gpm  
Est. Yield . . . . . gpm: Well water was . . . . . ft. after . . . . . hours pumping . . . . . gpm  
Bore Hole Diameter: 7 1/4 . . . . . in. to . . . 40 . . . . . ft., and . . . . . in. to . . . . . ft.  
WELL WATER TO BE USED AS: 5 Public water supply 8 Air conditioning 11 Injection well  
1 Domestic 3 Feedlot 6 Oil field water supply 9 Dewatering 12 Other (Specify below)  
2 Irrigation 4 Industrial 7 Lawn and garden only ~~10~~ Monitoring well . . . . .  
Was a chemical/bacteriological sample submitted to Department? Yes . . . . . No . . . . .; If yes, mo/day/yr sample was sub-  
mitted . . . . . Water Well Disinfected? Yes . . . . . No . . . . .

5 TYPE OF BLANK CASING USED:  
1 Steel 3 RMP (SR) 5 Wrought iron 8 Concrete tile CASING JOINTS: Glued . . . . . Clamped . . . . .  
X<sub>2</sub> PVC 2 ABS 6 Asbestos-Cement 9 Other (specify below) Welded . . . . .  
Blank casing diameter . . . . . in. to . . . 20 . . . . . ft., Dia . . . . . in. to . . . . . ft., Dia . . . . . in. to . . . . . ft.  
Casing height above land surface . . . . . in., weight . . . . . sched . . . . . lbs./ft. Wall thickness or gauge No. . . . .  
TYPE OF SCREEN OR PERFORATION MATERIAL:  
1 Steel 3 Stainless steel 5 Fiberglass X<sub>7</sub> PVC 10 Asbestos-cement  
2 Brass 4 Galvanized steel 6 Concrete tile 8 RMP (SR) 11 Other (specify) . . . . .  
9 ABS 12 None used (open hole)  
SCREEN OR PERFORATION OPENINGS ARE:  
1 Continuous slot X<sub>3</sub> Mill slot 0.10 5 Gauzed wrapped 8 Saw cut 11 None (open hole)  
2 Louvered shutter 4 Key punched 6 Wire wrapped 9 Drilled holes  
7 Torch cut 10 Other (specify) . . . . .  
SCREEN-PERFORATED INTERVALS: From . . . . 40 . . . . . ft. to . . . 20 . . . . . ft., From . . . . . ft. to . . . . . ft.  
From . . . . . ft. to . . . . . ft., From . . . . . ft. to . . . . . ft.  
GRAVEL PACK INTERVALS: From . . . . 40 . . . . . ft. to . . . 1.8 . . . . . ft., From . . . . . ft. to . . . . . ft.  
From . . . . . ft. to . . . . . ft., From . . . . . ft. to . . . . . ft.

6 GROUT MATERIAL: 1 Neat cement X<sub>2</sub> Cement grout 18 X<sub>8</sub> Bentonite 15 4 Other . . . . .  
Grout Intervals: From . . . . 15 . . . . . ft. to . . . -0.3 . . . . . ft., From . . . . . ft. to . . . . . ft., From . . . . . ft. to . . . . . ft.  
What is the nearest source of possible contamination:  
1 Septic tank 4 Lateral lines 7 Pit privy 10 Livestock pens 14 Abandoned water well  
2 Sewer lines 5 Cess pool 8 Sewage lagoon 11 Fuel storage 15 Oil well/Gas well  
X<sub>3</sub> Watertight sewer lines 6 Seepage pit 9 Feedyard 12 Fertilizer storage 16 Other (specify below)  
13 Insecticide storage  
Direction from well? south How many feet? 400

FROM	TO	LITHOLOGIC LOG	FROM	TO	PLUGGING INTERVALS
0	1	GRASS & TOPSOIL			
1	14	BRN SILTY CLAY			
14	22	BRN SANDY CLAY			
22	40	DRK BRN CLAYEY SAND			

7 CONTRACTOR'S OR LANDOWNER'S CERTIFICATION: This water well was (1) constructed, (2) reconstructed, or (3) plugged under my jurisdiction and was completed on (mo/day/year) 4-9-98 and this record is true to the best of my knowledge and belief. Kansas Water Well Contractor's License No. 575 This Water Well Record was completed on (mo/day/yr) 4-29-98 under the business name of KURTZ ENVIRONMENTAL SERVICE by (signature)

INSTRUCTIONS: Use typewriter or ball point pen. PLEASE PRESS FIRMLY and PRINT clearly. Please fill in blanks, underline or circle the correct answers. Send top three copies to Kansas Department of Health and Environment, Bureau of Water, Topeka, Kansas 66620-0001. Telephone: 913-296-5545. Send one to WATER WELL OWNER and retain one for your records.

OFFICE USE ONLY  
T  
R  
EW  
SEC.