

<b>1 LOCATION OF WATER WELL:</b> County: Ellsworth	Fraction NE¼ NE¼ NE¼ NW¼	Section Number 21	Township Number T 15 S	Range Number 8 <input type="checkbox"/> E <input checked="" type="checkbox"/> W
---	-----------------------------	----------------------	---------------------------	--


Street/Rural Address of Well Location; if unknown, distance & direction from nearest town or intersection: If at owner's address, check here   
Jct Hwy 140 & 156, Ellsworth, KS

**Global Positioning Systems (GPS) information:**  
Latitude: NA (in decimal degrees)  
Longitude: NA (in decimal degrees)  
Elevation: NA

Horizontal Datum  WGS84,  NAD83,  NAD27  
Collection Method:

**2 WATER WELL OWNER:** Bobbie E. Ott Trust I  
RR#, St. Address, Box #: PO Box 12  
City, State ZIP Code: Ellsworth, KS

GPS unit (Make/model: \_\_\_\_\_)  
 Digital Map/Photo,  Topographic Map  Land Survey  
Est. Accuracy:  <3 m,  3-5 m,  5-15 m,  >15 m

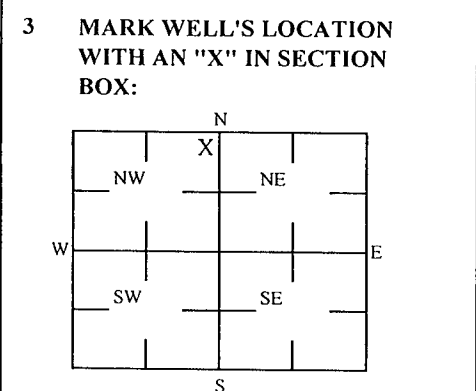

**4 DEPTH OF WELL** 46.40 ft. MW12  
WELL'S STATIC WATER LEVEL \_\_\_\_\_ ft  
WELL WAS USED AS:  
 Domestic  Public Water Supply  Dewatering  
 Irrigation  Oil Field Water Supply  Monitoring  
 Feedlot  Domestic (Lawn & Garden)  Injection Well  
 Industrial  Air Conditioning  Other \_\_\_\_\_  
Was a chemical/bacteriological sample submitted to Department? Yes  No

**5 TYPE OF BLANK CASING USED:**  
 Steel  RMP (SR)  Wrought  Fiberglass  Other (Specific below)  
 PVC  ABS  Asbestos-Cement  Concrete Tile  
Blank casing diameter 2 in. Was casing pulled? Yes  No  If yes, how much 3'  
Casing height above or below land surface NA in.

**6 GROUT PLUG MATERIAL:**  Neat cement  Cement grout  Bentonite  Other Gravel: 0-0.5'; Soil: 0.5-3'  
Grout Plug Intervals: From 3 ft to 46.40 ft, From \_\_\_\_\_ ft to \_\_\_\_\_ ft, From \_\_\_\_\_ ft to \_\_\_\_\_ ft.  
What is the nearest source of possible contamination:  
 Septic tank  Seepage pit  Fuel storage  Other (specify below)  
 Sewer lines  Pit privy  Fertilizer storage  
 Watertight sewer lines  Sewage lagoon  Insecticide storage  
 Lateral lines  Feed yard  Abandoned water well  
 Cess pool  Livestock pens  Oil well/Gas well  
Direction from well? \_\_\_\_\_  
How many feet? \_\_\_\_\_

FROM	TO	PLUGGING MATERIALS	FROM	TO	PLUGGING MATERIALS
0	0.5	Gravel			
0.5	3	Soil			
3	46.40	Bentonite			
KDHE ID: Cunningham Motors; U5-027-00843					

**7 CONTRACTOR'S OR LANDOWNER'S CERTIFICATION:** This water well was plugged under my jurisdiction and was completed on (mo/day/year) 2/18/2020 and this record is true to the best of my knowledge and belief. Kansas Water Contractor's License No. 757. This Water Well Record was completed on (mo/day/year) 2/25/2020 under the business name of Larsen & Associates, Inc. By (signature) \_\_\_\_\_

Send one white copy to Kansas Department of Health & Environment, Geology Section, 1000 SW Jackson Street, Ste. 420, Topeka, KS 66612-1367. Send one copy to WATER WELL OWNER and retain one for your records  
Visit us at <http://www.kdheks.gov/waterwell/index.html> Telephone 785-296-5524.

NOTE: Figures exhibited within this report are only to be used within the context of this report. Placement of property lines, wells, structures, and roads is based on the available information from county appraiser maps, surveys, site visits, and/or previous vendor reports and should be considered approximate.

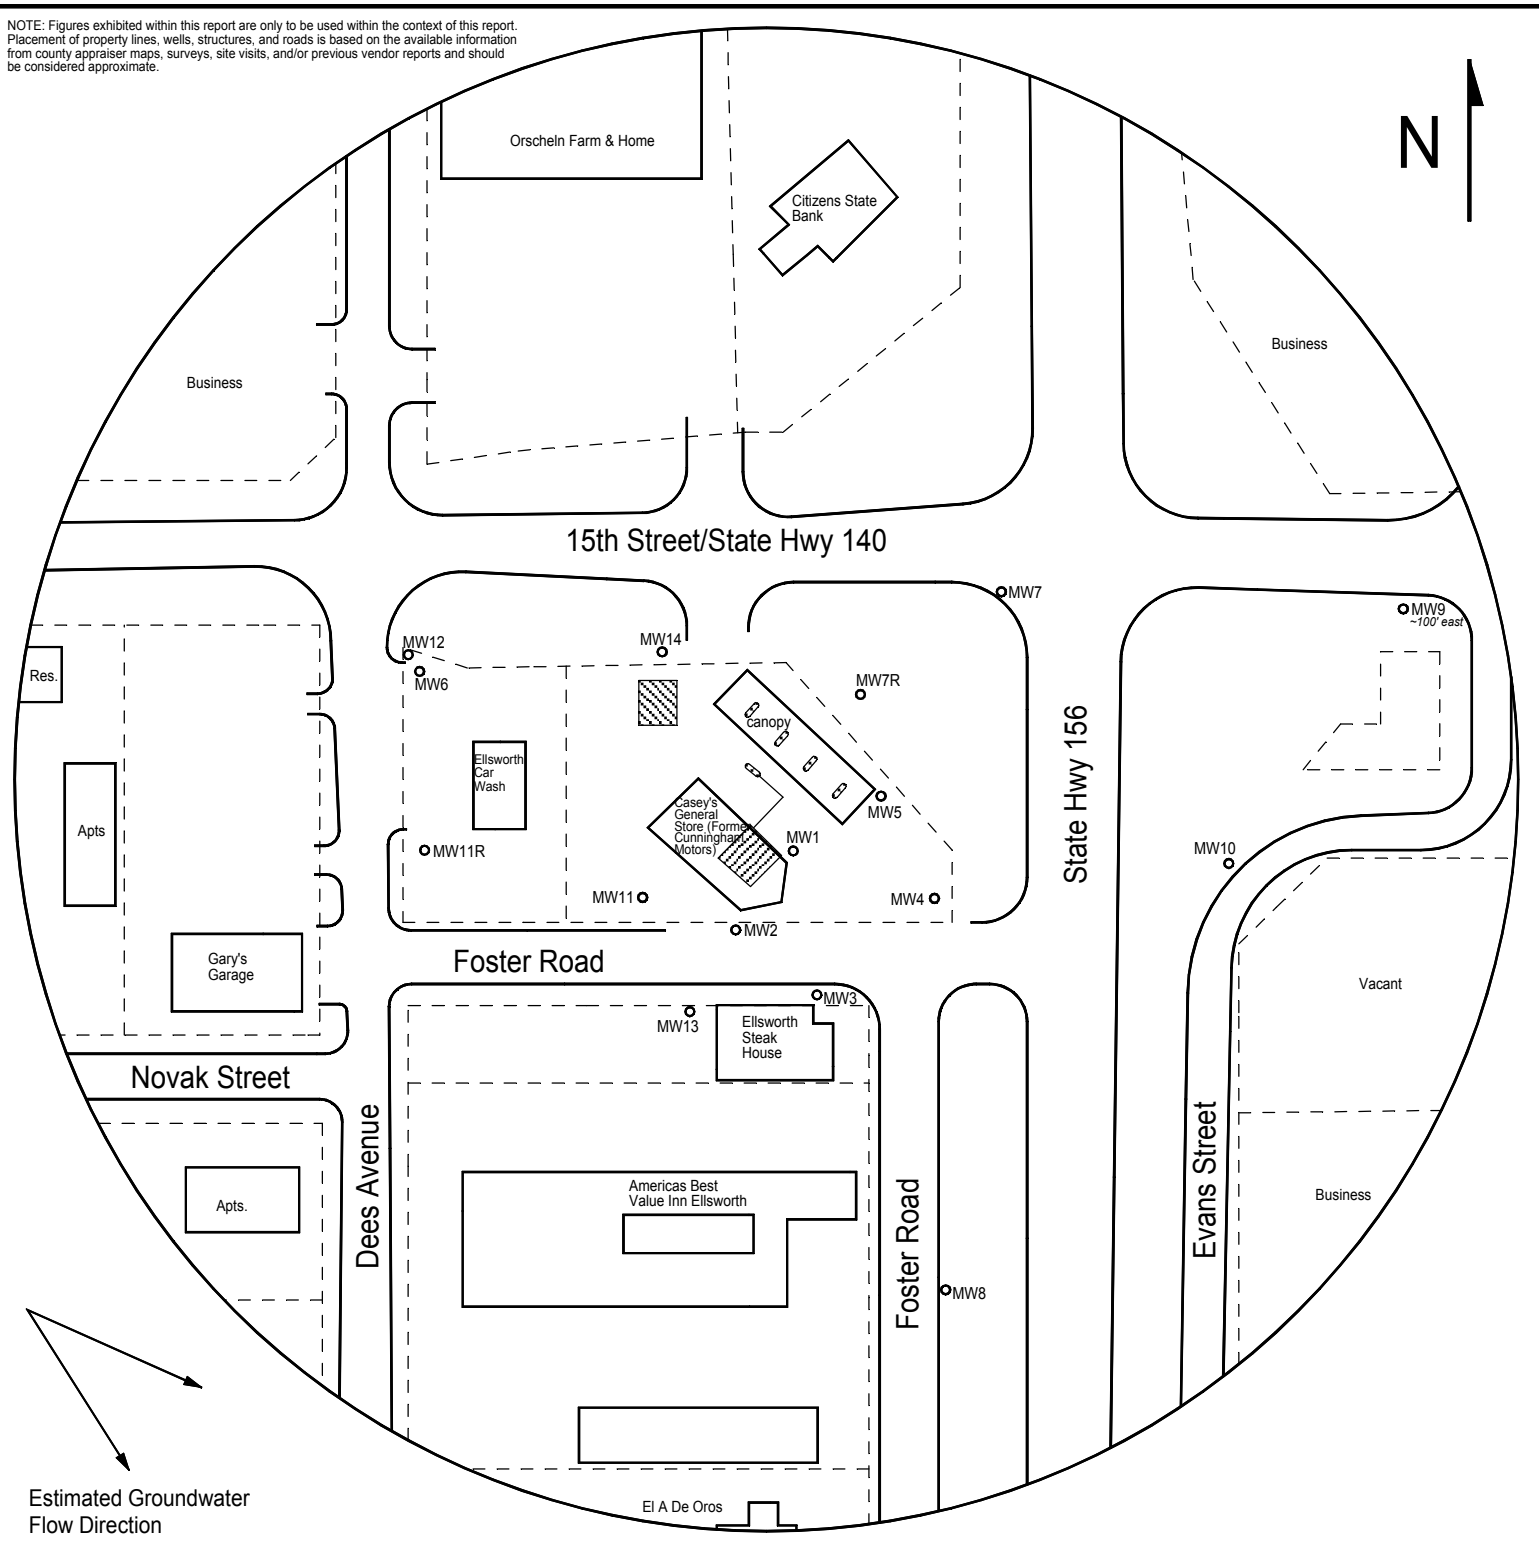


FIGURE 1 - 500 FT RADIUS AREA BASE MAP

**LEGEND**

- Approximate Location of Former UST Basin, Pump Island & Product Lines
- Approximate Location of Active UST Basin & Pump Islands
- Approximate Location of Property Line
- Plugged Well

**PROJECT:**

Cunningham Motors  
 Jct Hwy 140 & 156  
 Ellsworth, KS  
 KDHE ID: U5-027-00843  
 Date: 2/18/20



1311 E 25th St., Suite B    785-841-8707 office  
 Lawrence, KS 66046        785-865-4282 fax

NOTE: Utility depths, heights and locations are approximate.