


1 LOCATION OF WATER WELL: Fraction NE Section Number 15 Township Number T 15 S Range Number R 9 EW
 County: Ellsworth NEAR CENTER 1/4 NW 1/4

Distance and direction from nearest town or city street address of well if located within city?
3 1/2 Miles West & 1 Mile North of Ellsworth, Ks.

2 WATER WELL OWNER: Alvin Lange
 RR#, St. Address, Box # : R.R. #1 Board of Agriculture, Division of Water Resources
 City, State, ZIP Code : Ellsworth, Ks. 67439 Application Number:

3 LOCATE WELL'S LOCATION WITH AN "X" IN SECTION BOX:

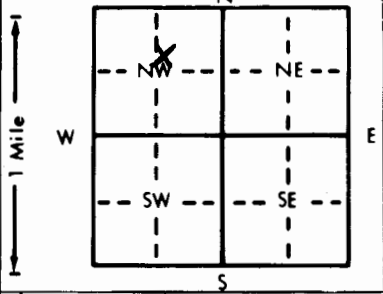

4 DEPTH OF COMPLETED WELL... 62 ft. ELEVATION:

Depth(s) Groundwater Encountered 1. 27 ft. 2. ft. 3. ft.

WELL'S STATIC WATER LEVEL ... 27 ft. below land surface measured on mo/day/yr ... 11/26/85

Pump test data: Well water was ... ft. after ... hours pumping ... gpm

Est. Yield ... 20 gpm: Well water was ... 28 ft. after ... 1 hours pumping ... 10 gpm

Bore Hole Diameter ... 8 in. to ... 62 ft., and ... in. to ... ft.

WELL WATER TO BE USED AS: 5 Public water supply 8 Air conditioning 11 Injection well
1 Domestic 3 Feedlot 6 Oil field water supply 9 Dewatering 12 Other (Specify below)

2 Irrigation 4 Industrial 7 Lawn and garden only 10 Observation well

Was a chemical/bacteriological sample submitted to Department? Yes.....No...X.....; If yes, mo/day/yr sample was submitted

Water Well Disinfected? Yes X No

5 TYPE OF BLANK CASING USED: 5 Wrought iron 8 Concrete tile CASING JOINTS: Glued ...X... Clamped

1 Steel 3 RMP (SR) 6 Asbestos-Cement 9 Other (specify below) Welded

2 PVC 4 ABS 7 Fiberglass Threaded

Blank casing diameter ... 5 in. to ... 52 ft., Dia ... in. to ... ft., Dia ... in. to ... ft.

Casing height above land surface ... 12 in., weight ... 2.91 lbs./ft. Wall thickness or gauge No. ... 265

TYPE OF SCREEN OR PERFORATION MATERIAL: 7 PVC 10 Asbestos-cement

1 Steel 3 Stainless steel 5 Fiberglass 8 RMP (SR) 11 Other (specify)

2 Brass 4 Galvanized steel 6 Concrete tile 9 ABS 12 None used (open hole)

SCREEN OR PERFORATION OPENINGS ARE: 5 Gauzed wrapped 8 Saw cut 11 None (open hole)

1 Continuous slot 3 Mill slot 6 Wire wrapped 9 Drilled holes

2 Louvered shutter 4 Key punched 7 Torch cut 10 Other (specify)

SCREEN-PERFORATED INTERVALS: From ... 52 ft. to ... 62 ft., From ... ft. to ... ft.

GRAVEL PACK INTERVALS: From ... 15 ft. to ... 62 ft., From ... ft. to ... ft.

6 GROUT MATERIAL: 1 Neat cement 2 Cement grout 3 Bentonite 4 Other

Grout Intervals: From ... 5 ft. to ... 15 ft., From ... ft. to ... ft., From ... ft. to ... ft.

What is the nearest source of possible contamination: 10 Livestock pens 14 Abandoned water well

Septic tank 4 Lateral lines 7 Pit privy 11 Fuel storage 15 Oil well/Gas well

2 Sewer lines 5 Cess pool 8 Sewage lagoon 12 Fertilizer storage 16 Other (specify below)

3 Watertight sewer lines 6 Seepage pit 9 Feedyard 13 Insecticide storage

Direction from well? SOUTH How many feet? 150 ft

FROM	TO	LITHOLOGIC LOG	FROM	TO	LITHOLOGIC LOG
0	3	Top Soil			
3	17	Medium Course Sand			
17	18	White Clay			
18	42	Light Sandstone			
42	53	Brown Sandstone			
53	62	Light Sandstone			

7 CONTRACTOR'S OR LANDOWNER'S CERTIFICATION: This water well was (1) constructed, (2) reconstructed, or (3) plugged under my jurisdiction and was completed on (mo/day/year) ... 11-26-85 ... and this record is true to the best of my knowledge and belief. Kansas Water Well Contractor's License No. ... 138 ... This Water Well Record was completed on (mo/day/yr) ... 12-5-85 ... under the business name of Peterson Irrigation, Inc. by (signature) Mike Peterson

INSTRUCTIONS: Use typewriter or ball point pen, PLEASE PRESS FIRMLY and PRINT clearly. Please fill in blanks, underline or circle the correct answers. Send top three copies to Kansas Department of Health and Environment, Division of Environment, Environmental Geology Section, Topeka, KS 66620. Send one to WATER WELL OWNER and retain one for your records.

OFFICE USE ONLY

T

R

EW

SEC.

1/4

1/4

1/4