


1 LOCATION OF WATER WELL: County: <u>Ellsworth</u>	Fraction <u>NW</u> 1/4 <u>NW</u> 1/4 <u>NE</u> 1/4	Section Number <u>25</u>	Township Number T <u>15</u> S	Range Number R <u>9W</u> E/W
---	---	-----------------------------	----------------------------------	---------------------------------

Distance and direction from nearest town or city street address of well if located within city?
1 3/4 W of Ellsworth, Kansas

2 WATER WELL OWNER: <u>Jim Pickens</u>	<u>Woodman & Iannitti</u>	<u>Pickens No. 1</u>
RR#, St. Address, Box # : <u>Ellsworth, Ks.</u>	<u>104 S. Broadway</u>	Board of Agriculture, Division of Water Resources
City, State, ZIP Code : <u>67439</u>	<u>Wichita, Ks. 67202</u>	Application Number: <u>Unknown</u>

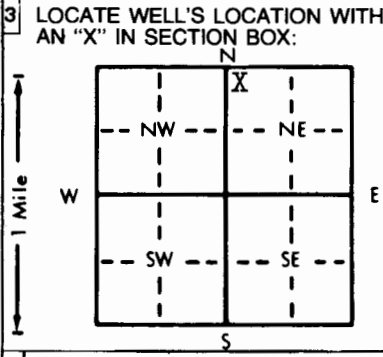

4 DEPTH OF COMPLETED WELL... 65 ft. ELEVATION: Unknown

Depth(s) Groundwater Encountered 1.18 ft. 2. ft. 3. ft.

WELL'S STATIC WATER LEVEL 18 ft. below land surface measured on mo/day/yr 6/5/84

Pump test data: Well water was ft. after hours pumping gpm

Est. Yield . . . 60 . . . gpm: Well water was ft. after hours pumping gpm

Bore Hole Diameter. . . 8 . . . in. to 65 ft., and. in. to ft.

WELL WATER TO BE USED AS:

5 Public water supply	8 Air conditioning	11 Injection well
1 Domestic	3 Feedlot	<u>6 Oil field water supply</u>
2 Irrigation	4 Industrial	7 Lawn and garden only
		10 Observation well

9 Dewatering
 12 Other (Specify below) |

Was a chemical/bacteriological sample submitted to Department? Yes. No; If yes, mo/day/yr sample was submitted

Water Well Disinfected? Yes No

5 TYPE OF BLANK CASING USED:

1 Steel	3 RMP (SR)	6 Asbestos-Cement	9 Other (specify below)	CASING JOINTS: <u>Glued</u> Clamped
<u>2 PVC</u>	4 ABS	7 Fiberglass		Welded
				Threaded

Blank casing diameter 5 in. to 45 ft., Dia in. to ft., Dia in. to ft.

Casing height above land surface. 12 in., weight 2.8 lbs./ft. Wall thickness or gauge No. Sch. 40

TYPE OF SCREEN OR PERFORATION MATERIAL:

1 Steel	3 Stainless steel	5 Fiberglass	8 RMP (SR)	10 Asbestos-cement
2 Brass	4 Galvanized steel	6 Concrete tile	9 ABS	11 Other (specify)
				12 None used (open hole)

SCREEN OR PERFORATION OPENINGS ARE:

1 Continuous slot	3 Mill slot	5 Gauzed wrapped	<u>8 Saw cut</u>	11 None (open hole)
2 Louvered shutter	4 Key punched	6 Wire wrapped	9 Drilled holes	
		7 Torch cut	10 Other (specify)	

SCREEN-PERFORATED INTERVALS: From 45 ft. to 65 ft., From ft. to ft., From ft. to ft.

GRAVEL PACK INTERVALS: From 10 ft. to 65 ft., From ft. to ft., From ft. to ft.

6 GROUT MATERIAL: 1 Neat cement 2 Cement grout 3 Bentonite 4 Other

Grout Intervals: From 0 ft. to 10 ft., From ft. to ft., From ft. to ft.

What is the nearest source of possible contamination:

1 Septic tank	4 Lateral lines	7 Pit privy	10 Livestock pens	14 Abandoned water well
2 Sewer lines	5 Cess pool	8 Sewage lagoon	11 Fuel storage	<u>15 Oil well/Gas well</u>
3 Watertight sewer lines	6 Seepage pit	9 Feedyard	12 Fertilizer storage	16 Other (specify below)
			13 Insecticide storage	

Direction from well? South How many feet? 60

FROM	TO	LITHOLOGIC LOG	FROM	TO	LITHOLOGIC LOG
0	8	Clay			
8	65	Sand rock			

7 CONTRACTOR'S OR LANDOWNER'S CERTIFICATION: This water well was (1) constructed, (2) reconstructed, or (3) plugged under my jurisdiction and was completed on (mo/day/year) . . . 6/5/84 and this record is true to the best of my knowledge and belief. Kansas Water Well Contractor's License No. . . 186 This Water Well Record was completed on (mo/day/yr) 7/29/84

under the business name of Kellys Water Well Service by (signature) [Signature]

INSTRUCTIONS: Use typewriter or ball point pen, PLEASE PRESS FIRMLY and PRINT clearly. Please fill in blanks, underline or circle the correct answers. Send top three copies to Kansas Department of Health and Environment, Division of Environment, Environmental Geology Section, Topeka, KS 66620. Send one to WATER WELL OWNER and retain one for your records.

OFFICE USE ONLY
T
R
E/W
SEC.
1/4
1/4
1/4