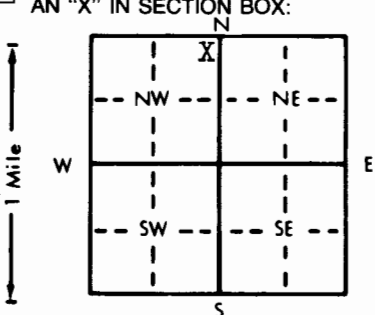


1 LOCATION OF WATER WELL: Fraction NE 1/4 NE 1/4 NW 1/4 Section Number 26 Township Number T 15 S Range Number R 9W E/W  
 County: Ellsworth

Distance and direction from nearest town or city street address of well if located within city?  
3 W of Ellsworth, Kansas

2 WATER WELL OWNER: Richard Daniels  
 RR#, St. Address, Box # : 3400 Liberty Lane Board of Agriculture, Division of Water Resources  
 City, State, ZIP Code : Marietta, Georgia 30062 Application Number: None

3 LOCATE WELL'S LOCATION WITH AN "X" IN SECTION BOX:  4 DEPTH OF COMPLETED WELL: 180 ft. ELEVATION: Unknown  
 Depth(s) Groundwater Encountered 1.115 ft. 2.          ft. 3.          ft.  
 WELL'S STATIC WATER LEVEL 115 ft. below land surface measured on mo/day/yr 6/7/84  
 Pump test data: Well water was          ft. after          hours pumping          gpm  
 Est. Yield 60 gpm: Well water was          ft. after          hours pumping          gpm  
 Bore Hole Diameter .8 in. to 180 ft., and          in. to          ft.  
 WELL WATER TO BE USED AS:  
 5 Public water supply 8 Air conditioning 11 Injection well  
 1 Domestic 3 Feedlot 6 Oil field water supply 9 Dewatering 12 Other (Specify below)  
 2 Irrigation 4 Industrial 7 Lawn and garden only 10 Observation well  
 Was a chemical/bacteriological sample submitted to Department? Yes No; If yes, mo/day/yr sample was submitted           
 Water Well Disinfected? Yes          No         

5 TYPE OF BLANK CASING USED:  
 1 Steel 3 RMP (SR) 5 Wrought iron 8 Concrete tile CASING JOINTS: Glued Clamped           
 2 PVC 4 ABS 6 Asbestos-Cement 9 Other (specify below) Welded  
 7 Fiberglass          Threaded           
 Blank casing diameter 5 in. to 160 ft., Dia.          in. to          ft., Dia.          in. to          ft.  
 Casing height above land surface 12 in., weight 2.8 lbs./ft. Wall thickness or gauge No. Sch. 40  
 TYPE OF SCREEN OR PERFORATION MATERIAL:  
 1 Steel 3 Stainless steel 5 Fiberglass 7 PVC 10 Asbestos-cement  
 2 Brass 4 Galvanized steel 6 Concrete tile 8 RMP (SR) 11 Other (specify)           
 9 ABS 12 None used (open hole)  
 SCREEN OR PERFORATION OPENINGS ARE:  
 1 Continuous slot 3 Mill slot 5 Gauzed wrapped 8 Saw cut 11 None (open hole)  
 2 Louvered shutter 4 Key punched 6 Wire wrapped 9 Drilled holes  
 7 Torch cut 10 Other (specify)           
 SCREEN-PERFORATED INTERVALS: From 160 ft. to 180 ft., From          ft. to          ft.  
 From          ft. to          ft., From          ft. to          ft.  
 GRAVEL PACK INTERVALS: From 10 ft. to 180 ft., From          ft. to          ft.  
 From          ft. to          ft., From          ft. to          ft.

6 GROUT MATERIAL: 1 Neat cement 2 Cement grout 3 Bentonite 4 Other           
 Grout Intervals: From 0 ft. to 10 ft., From          ft. to          ft., From          ft. to          ft.  
 What is the nearest source of possible contamination:  
 1 Septic tank 4 Lateral lines 7 Pit privy 10 Livestock pens 14 Abandoned water well  
 2 Sewer lines 5 Cess pool 8 Sewage lagoon 11 Fuel storage 15 Oil well/Gas well  
 3 Watertight sewer lines 6 Seepage pit 9 Feedyard 12 Fertilizer storage 16 Other (specify below)  
 13 Insecticide storage           
 Direction from well? South How many feet? 100

FROM	TO	LITHOLOGIC LOG	FROM	TO	LITHOLOGIC LOG
0	120	Clay			
120	180	Sand Rock			

7 CONTRACTOR'S OR LANDOWNER'S CERTIFICATION: This water well was (1) constructed, (2) reconstructed, or (3) plugged under my jurisdiction and was completed on (mo/day/year) 6/7/84 and this record is true to the best of my knowledge and belief. Kansas Water Well Contractor's License No. 186 This Water Well Record was completed on (mo/day/yr) 7/29/84 under the business name of Kellys Water Well Service by (signature) [Signature]

INSTRUCTIONS: Use typewriter or ball point pen, PLEASE PRESS FIRMLY and PRINT clearly. Please fill in blanks, underline or circle the correct answers. Send top three copies to Kansas Department of Health and Environment, Division of Environment, Environmental Geology Section, Topeka, KS 66620. Send one to WATER WELL OWNER and retain one for your records.