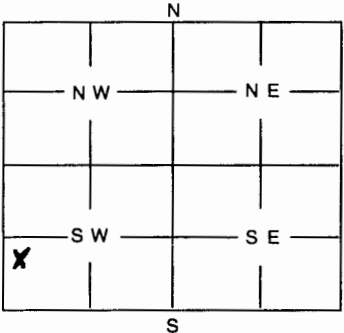


1	LOCATION OF WATER WELL:	Fraction	Section Number	Township Number	Range Number
County:	Ellsworth	NW 1/4 SW 1/4 SW 1/4	10	16	10

Distance and direction from nearest town or city street address of well if located within city?

N/A

2	WATER WELL OWNER: Donald Kozisek	Board of Agriculture, Division of Water Resources
RR #, St. Address, Box #:	1576 4th Road	Application Number:
City, State, ZIP Code :	Holyrood, KS 67450	

3	MARK WELL'S LOCATION WITH AN "X" IN SECTION BOX:	4	DEPTH OF WELL 252 ft.
		WELL'S STATIC WATER LEVEL ft. WELL WAS USED AS: ① Domestic 5 Public Water Supply 9 Dewatering 2 Irrigation 6 Oil Field Water Supply 10 Monitoring Well 3 Feedlot 7 Domestic (Lawn & Garden) 11 Injection Well 4 Industrial 8 Air Conditioning 12 Other	
Was a chemical / bacteriological sample submitted to Department? Yes No <u>X</u> If yes, mo/day/yr sample was submitted Water Well Disinfected: Yes No <u>X</u>			

5	TYPE OF BLANK CASING USED:			
1 Steel	3 RMP (SR)	5 Wrought	7 Fiberglass	⑨ Other (Specify below)
2 PVC	4 ABS	6 Asbestos-Cement	8 Concrete Tile	<u>Galvanized metal</u>
Blank casing diameter <u>6</u> in. Was casing pulled? Yes No <u>X</u> If yes, how much				
Casing height above or below land surface <u>36</u> in. <u>below</u>				

6	GROUT PLUG MATERIAL: 1 Neat cement 2 Cement grout ③ Bentonite 4 Other			
Grout Plug Intervals: From <u>252</u> ft. to <u>245</u> ft., From <u>10</u> ft. to <u>3</u> ft., From to ft.				
What is the nearest source of possible contamination:				
1 Septic tank	6 Seepage pit	11 Fuel storage	16 Other (specify below)	
2 Sewer lines	7 Pit privy	12 Fertilizer storage		
3 Watertight sewer lines	8 Sewage lagoon	13 Insecticide storage		
4 Lateral lines	9 Feedyard	14 Abandoned water well		
5 Cess Pool	⑩ Livestock pens	15 Oil well/Gas well		
Direction from well? <u>North east</u> How many feet? <u>20</u>				

FROM	TO	PLUGGING MATERIALS
252	245	Bentonite
245	10	Subsoil Clays
10	3	Bentonite
3	0	Subsoil

7	CONTRACTOR'S OR LANDOWNER'S CERTIFICATION: This water well was plugged under my jurisdiction and was completed on (mo/day/year) <u>12-8-2003</u> and this record is true to the best of my knowledge and belief. Kansas Water Well Contractor's License No. <u>1-9-2004</u> under the business name of <u>Landowner</u> This Water Well Record was completed on (mo/day/year) <u>1-9-2004</u>	
by (signature) <u>Donald Kozisek</u>		

INSTRUCTIONS: Use typewriter or ball point pen. Please press firm xy and print clearly. Please fill in blanks, underline or circle the correct answers. Send top three copies to Kansas Department of Health and Environment, Bureau of Water, Topeka, Kansas 66620-0001. Telephone: 785/296-3565. Send one to Water Well Owner and retain one for your records.