

WATER WELL PLUGGING RECORD Form WWC-5P

KSA 82a-1212

ID NO.

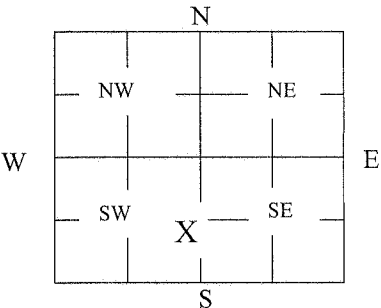
MW-3

1 LOCATION OF WATER WELL: Barton County	Fraction NE ¼ SE ¼ SW ¼	Section Number 30	Township Number 16 S	Range Number R 11 W
--	----------------------------	----------------------	-------------------------	------------------------

Distance and direction from nearest town or city street address of well if located within city?

Well was located at RR #1, Box 139 Hitschmann, KS

2 WATER WELL OWNER: Ellsworth County Farmers Coop RR#, St. Address, Box #: P.O. Box 397 City, State ZIP Code: Ellsworth, KS 67439	Global Positioning Systems (decimal degrees, min. of 4 digits) Latitude: _____ Longitude: _____ Elevation: _____ Datum: _____ Data Collection Method: _____
--	--

3 MARK WELL'S LOCATION WITH AN "X" IN SECTION BOX: 	4 DEPTH OF WELL <u>20.95</u> ft. WELL'S STATIC WATER LEVEL <u>16.16</u> ft. WELL WAS USED AS: <input checked="" type="checkbox"/> X <table border="0"> <tr> <td>1 Domestic</td> <td>5 Public Water Supply</td> <td>9 Dewatering</td> </tr> <tr> <td>2 Irrigation</td> <td>6 Oil Field Water Supply</td> <td><u>10 Monitoring</u></td> </tr> <tr> <td>3 Feedlot</td> <td>7 Domestic (Lawn & Garden)</td> <td>11 Injection Well</td> </tr> <tr> <td>4 Industrial</td> <td>8 Air Conditioning</td> <td>12 Other _____</td> </tr> </table> Was a chemical/bacteriological sample submitted to Department? Yes _____ No <u>x</u> _____	1 Domestic	5 Public Water Supply	9 Dewatering	2 Irrigation	6 Oil Field Water Supply	<u>10 Monitoring</u>	3 Feedlot	7 Domestic (Lawn & Garden)	11 Injection Well	4 Industrial	8 Air Conditioning	12 Other _____
1 Domestic	5 Public Water Supply	9 Dewatering											
2 Irrigation	6 Oil Field Water Supply	<u>10 Monitoring</u>											
3 Feedlot	7 Domestic (Lawn & Garden)	11 Injection Well											
4 Industrial	8 Air Conditioning	12 Other _____											

5 TYPE OF BLANK CASING USED: <table border="0"> <tr> <td>1 Steel</td> <td>3 RMP (SR)</td> <td>5 Wrought</td> <td>7 Fiberglass</td> <td>9 Other (Specify below)</td> </tr> <tr> <td><u>2 PVC</u></td> <td>4 ABS</td> <td>6 Asbestos-Cement</td> <td>8 Concrete Tile</td> <td>_____</td> </tr> </table> Blank casing diameter <u>2</u> in. Was casing pulled? Yes <u>x</u> No _____ If yes, how much <u>3'</u> Casing height above or below land surface <u>36</u> in.	1 Steel	3 RMP (SR)	5 Wrought	7 Fiberglass	9 Other (Specify below)	<u>2 PVC</u>	4 ABS	6 Asbestos-Cement	8 Concrete Tile	_____
1 Steel	3 RMP (SR)	5 Wrought	7 Fiberglass	9 Other (Specify below)						
<u>2 PVC</u>	4 ABS	6 Asbestos-Cement	8 Concrete Tile	_____						

6 GROUT PLUG MATERIAL:	1 Neat cement	2 Cement grout	3 Bentonite	4 Other <u>Soil</u>
------------------------	---------------	----------------	-------------	---------------------

Grout Plug Intervals: From 4 0 ft. to 3 ft., From 3 3 ft. to 20.95 ft., From _____ to _____ ft.

What is the nearest source of possible contamination:

1 Septic tank	6 Seepage pit	11 Fuel Storage	16 Other (specify below)
2 Sewer lines	7 Pit privy	12 Fertilizer storage	<u>Contaminated Site</u>
3 Watertight sewer lines	8 Sewage lagoon	13 Insecticide storage	
4 Lateral lines	9 Feedyard	14 Abandoned water well	Direction from well? _____
5 Cess pool	10 Livestock pens	15 Oil well/Gas well	How many feet? _____

FROM	TO	PLUGGING MATERIALS	FROM	TO	PLUGGING MATERIALS
0'	3'	Soil			
3'	20.95'	Bentonite Chips			

7 CONTRACTOR'S OR LANDOWNER'S CERTIFICATION: This water well was plugged under my jurisdiction and was completed on (mo/day/year) 08/26/13 and this record is true to the best of my knowledge and belief. Kansas Water Well Contractor's License No. 585. This Water Well Record was completed on (mo/day/year) 08/27/13 under the business name of Associated Environmental, Inc. by (signature) [Signature]

INSTRUCTIONS: Use typewriter or ballpoint pen. Please press firmly and print clearly. Please fill in blanks, underline or circle the correct answers. Send top three copies to Kansas Department of Health and Environment, Bureau of Water, Geology Section, 1000 SW Jackson St., Ste. 420, Topeka, Kansas 66612-1367. Telephone: 785/296-5522. Send one to Water Well Owner and retain one for your records. Visit us at <http://www.kdheks.gov/waterwell/index.html>.