

# WATER WELL PLUGGING RECORD Form WWC-5P

KSA 82a-1212

ID NO.

1 LOCATION OF WATER WELL: County: <b>Barton</b>	Fraction <b>SW 1/4 NE 1/4 NW 1/4 NE 1/4</b>	Section Number <b>27</b>	Township Number <b>16 T 36 S</b>	Range Number <b>11</b> <input type="checkbox"/> E <input checked="" type="checkbox"/> W
--	--	-----------------------------	-------------------------------------	--

Street/Rural Address of Well Location; if unknown, distance & direction from nearest town or intersection: If at owner's address, check here ☒

## Global Positioning Systems (GPS) information:

Latitude: **38.63708** (in decimal degrees)

Longitude: **98.52376** (in decimal degrees)

Elevation: **1920'**

Horizontal Datum: ☒ WGS84, ☐ NAD83, ☐ NAD27

Collection Method:


☐ GPS unit (Make/Model: **Google maps**)

☒ Digital Map/Photo, ☐ Topographic Map, ☐ Land Survey

Est. Accuracy: ☐ < 3 m, ☒ 3-5 m, ☐ 5-15 m, ☐ > 15 m

2 WATER WELL OWNER: **Jack Willenberg**  
RR#, St. Address, Box #: **1371 NE 190 Rd**  
City, State ZIP Code: **Clafin, KS 67525**

## 3 MARK WELL'S LOCATION WITH AN "X" IN SECTION BOX:

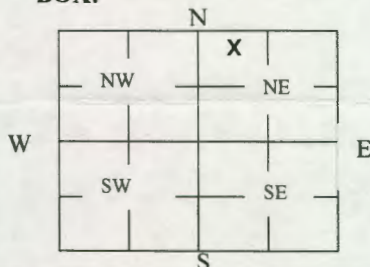

## 4 DEPTH OF WELL **21** ft.

WELL'S STATIC WATER LEVEL **9'** from top ft

WELL WAS USED AS:

☐ Domestic  
☐ Irrigation  
☐ Feedlot  
☐ Industrial

☐ Public Water Supply  
☐ Oil Field Water Supply  
☐ Domestic (Lawn & Garden)  
☐ Air Conditioning

☐ Dewatering  
☐ Monitoring  
☐ Injection Well  
☒ Other **Abandoned Ag.**

Was a chemical/bacteriological sample submitted to Department? Yes ☐ No ☒

## 5 TYPE OF BLANK CASING USED:

☐ Steel  
☐ PVC

☐ RMP (SR)  
☐ ABS

☐ Wrought  
☐ Asbestos-Cement

☐ Fiberglass  
☐ Concrete Tile

☒ Other (Specify below)  
**Limestone rock lined**

Blank casing diameter **48** in. Was casing pulled? Yes ☒ No ☐ If yes, how much **6'**  
Casing height above or below land surface **0** in.

## 6 GROUT PLUG MATERIAL: ☐ Neat cement ☐ Cement grout ☒ Bentonite ☐ Other

Grout Plug Intervals: From **5.5** ft. to **6** ft., From \_\_\_\_\_ ft. to \_\_\_\_\_ ft., From \_\_\_\_\_ ft. to \_\_\_\_\_ ft.

What is the nearest source of possible contamination:

☐ Septic tank  
☒ Sewer lines  
☐ Watertight sewer lines  
☐ Lateral lines  
☐ Cess pool

☐ Seepage pit  
☐ Pit privy  
☐ Sewage lagoon  
☐ Feedyard  
☐ Livestock pens

☐ Fuel storage  
☐ Fertilizer storage  
☐ Insecticide storage  
☐ Abandoned water well  
☐ Oil well/Gas well

☐ Other (specify below)

Direction from well? **East**

How many feet? **300'**

FROM	TO	PLUGGING MATERIALS	FROM	TO	PLUGGING MATERIALS
21'	9'	Sand			
9'	6'	Clay fill			
6'	5.5'	Bentonite clay			
5.5'	0	Soil			

7 CONTRACTOR'S OR LANDOWNER'S CERTIFICATION: This water well was plugged under my jurisdiction and was completed on (mo/day/year) **5/14/2023** and this record is true to the best of my knowledge and belief. Kansas Water Well Contractor's License No. \_\_\_\_\_ This Water Well Record was completed on (mo/day/year) \_\_\_\_\_ under the business name of \_\_\_\_\_ by (signature) *[Signature]*

Send one white copy to Kansas Department of Health & Environment, Geology Section, 3000 SW Jackson St., Ste. 420, Topeka, KS 66612-1367. Send one copy to WATER WELL OWNER and retain one for your records.

Visit us at <http://www.kdheks.gov/waterwell/index.html> Telephone 785-296-5524.

KSA82a-1212

Revised 1/20/2015