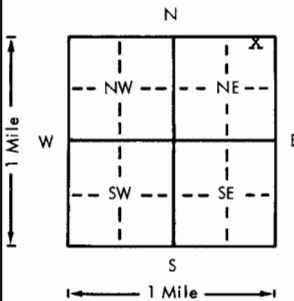


USE TYPEWRITER OR BALL
POINT PEN-PRESS FIRMLY,
PRINT CLEARLY.

WATER WELL RECORD
KSA 82a-1201-1215

Kansas Department of Health and
Environment-Division of Environment
(Water well Contractors)
Topeka, Kansas 66620

1. Location of well:		County Barton	Fraction 1/4 NE 1/4 NE 1/4	Section number 3	Township number T 16 S R 11 E	Range number 11
2. Distance and direction from nearest town or city: XX 11 miles North of Claflin, KS Street address of well location if in city:				3. Owner of well: Tom H. Phillips R.R. or street: 2257 Roach City, state, zip code: Salina, KS 67401		
4. Locate with "X" in section below:		Sketch map:		6. Bore hole dia. 9 in. Completion date 1-4-77 Well depth 218 ft.		
				7. <input type="checkbox"/> Cable tool <input type="checkbox"/> Rotary <input type="checkbox"/> Driven <input type="checkbox"/> Dug <input type="checkbox"/> Hollow rod <input type="checkbox"/> Jetted <input type="checkbox"/> Bored <input checked="" type="checkbox"/> Reverse rotary		
5. Type and color of material		From	To	8. Use: <input checked="" type="checkbox"/> Domestic <input type="checkbox"/> Public supply <input type="checkbox"/> Industry <input type="checkbox"/> Irrigation <input type="checkbox"/> Air conditioning <input type="checkbox"/> Stock <input type="checkbox"/> Lawn <input type="checkbox"/> Oil field water <input type="checkbox"/> Other		
top soil		0	1	9. Casing: Material Styrene Height: Above or below Threaded <input type="checkbox"/> Welded <input checked="" type="checkbox"/> Surface 12 in. RMP <input type="checkbox"/> PVC <input type="checkbox"/> Weight 1.5 lbs./ft. Dia. 5 in. to 130 ft. depth Wall Thickness inches or Dia. 5 in. to 188 ft. depth gage No. 200		
limestone		1	8	10. Screen: Manufacturer's name Lowell Jess & Type Styrene 200 Dia. 5" <input checked="" type="checkbox"/> Slot gauze 1/8 Length 50' Set between 130 ft. and 150 ft. 188 ft. and 218 ft. Gravel pack yes Size range of material 3/8-200		
blue shale & hard limestone streaks		8	130	11. Static water level: 37'10" ft. below land surface Date 1-3-77 mo./day/yr.		
white clay & sandstone streaks		130	145	12. Pumping level below land surfaces: N/C ____ ft. after ____ hrs. pumping ____ g.p.m. ____ ft. after ____ hrs. pumping ____ g.p.m. Estimated maximum yield ____ g.p.m.		
blue shale & limestone streaks		145	191	13. Water sample submitted: ____ mo./day/yr. Yes <input checked="" type="checkbox"/> No <input type="checkbox"/> Date ____		
white clay & sandstone streaks		191	210	14. Well head completion: ____ Pitless adapter ____ 12 inches above grade		
sandstone		210	217	15. Well grouted? yes With: <input checked="" type="checkbox"/> Neat cement ____ Bentonite ____ Concrete ____ Depth: From 0 ft. to 10 ft.		
red & white clay		217	218	16. Nearest source of possible contamination: ft. ____ Direction ____ Type ____ Well disinfected upon completion? <input checked="" type="checkbox"/> Yes ____ No ____		
				17. Pump: ____ Not installed Manufacturer's name Berkeley Pump Model number 4AM-11 HP 1/2 Volts 220 Length of drop pipe 168 ft. capacity 10 g.p.m. Type: <input checked="" type="checkbox"/> Submersible ____ Turbine ____ Jet ____ Reciprocating ____ Centrifugal ____ Other ____		
		(Use a second sheet if needed)				
18. Elevation:		19. Remarks:		20. Water well contractor's certification: This well was drilled under my jurisdiction and this report is true to the best of my knowledge and belief. Clarke Well & Eq., Inc. 185 Business name Address Great Bend, KS 67530 License No. ____ Signed [Signature] Date 1-6-77 Authorized representative		
Topography: ____ Hill ____ Slope ____ Upland ____ Valley						

Forward the white, blue and pink copies to the Department of Health and Environment

Form WWC-5