


1 LOCATION OF WATER WELL: County: Barton Fraction: NE 1/4 NE 1/4 SE 1/4 Section Number: 36 Township Number: T 16 S Range Number: R 12 E

Distance and direction from nearest town or city street address of well if located within city?
From Hwy #4 & NE 100 Ave 6 1/2 mi North West into

2 WATER WELL OWNER: Robert Bonomo
 RR#, St. Address, Box #: 809 Coolidge #112 Board of Agriculture, Division of Water Resources
 City, State, ZIP Code: Great Bend KS 67530 Application Number:

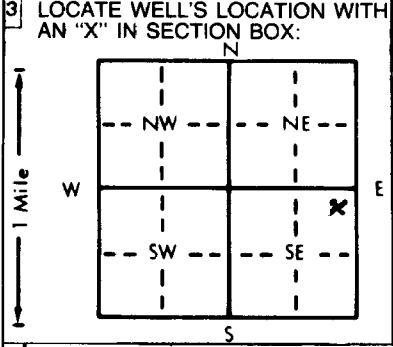

4 DEPTH OF COMPLETED WELL: 280 ft. ELEVATION:
 Depth(s) Groundwater Encountered 1. 250 ft. 2. ft. 3. ft.
 WELL'S STATIC WATER LEVEL: 180 ft. below land surface measured on mo/day/yr 6-8-00
 Pump test data: Well water was ft. after hours pumping gpm
 Est. Yield gpm; Well water was ft. after hours pumping gpm
 Bore Hole Diameter: 8 3/4 in. to 260 ft., and in. to ft.
 WELL WATER TO BE USED AS:
 5 Public water supply 8 Air conditioning 11 Injection well
 1 Domestic 3 Feedlot 6 Oil field water supply 9 Dewatering X Other (Specify below)
 2 Irrigation 4 Industrial 7 Lawn and garden only 10 Monitoring well Livestock
 Was a chemical/bacteriological sample submitted to Department? Yes No X; if yes, mo/day/yr sample was submitted
 Water Well Disinfected? Yes X No

5 TYPE OF BLANK CASING USED:
 1 Steel 3 RMP (SR) 5 Wrought iron 8 Concrete tile CASING JOINTS: Glued X Clamped
 2 PVC 4 ABS 6 Asbestos-Cement 9 Other (specify below) Welded
 7 Fiberglass Threaded
 Blank casing diameter: 5 in. to 260 ft., Dia in. to ft., Dia in. to ft.
 Casing height above land surface: 18 in., weight 200 pcf lbs./ft. Wall thickness or gauge No.
 TYPE OF SCREEN OR PERFORATION MATERIAL: X PVC 10 Asbestos-cement
 1 Steel 3 Stainless steel 5 Fiberglass 8 RMP (SR) 11 Other (specify)
 2 Brass 4 Galvanized steel 6 Concrete tile 9 ABS 12 None used (open hole)
 SCREEN OR PERFORATION OPENINGS ARE:
 5 Gauzed wrapped X Saw cut 11 None (open hole)
 1 Continuous slot 3 Mill slot 6 Wire wrapped 9 Drilled holes
 2 Louvered shutter 4 Key punched 7 Torch cut 10 Other (specify)
 SCREEN-PERFORATED INTERVALS: From 240 ft. to 260 ft., From ft. to ft.
 From ft. to ft., From ft. to ft.
 GRAVEL PACK INTERVALS: From 220 ft. to 260 ft., From ft. to ft.
 From ft. to ft., From ft. to ft.

6 GROUT MATERIAL: 1 Neat cement 2 Cement grout X Bentonite 4 Other
 Grout Intervals: From 220 ft. to 5 ft., From ft. to ft., From ft. to ft.
 What is the nearest source of possible contamination:
 1 Septic tank 4 Lateral lines 7 Pit privy X Livestock pens 14 Abandoned water well
 2 Sewer lines 5 Cess pool 8 Sewage lagoon 11 Fuel storage 15 Oil well/Gas well
 3 Watertight sewer lines 6 Seepage pit 9 Feedyard 12 Fertilizer storage 16 Other (specify below)
 13 Insecticide storage
 Direction from well? South How many feet? 75' Down grade

FROM	TO	LITHOLOGIC LOG	FROM	TO	PLUGGING INTERVALS
0	4	Soil			
4	35	lime stone			
35	200	Black Shale & lime stone			
200	220	Red Shale			
220	240	Iron Pyrite & Blue Shale			
240	250	Blue Shale			
250	260	White Sand Rock			

7 CONTRACTOR'S OR LANDOWNER'S CERTIFICATION: This water well was X constructed, (2) reconstructed, or (3) plugged under my jurisdiction and was completed on (mo/day/year) 6-5-00 and this record is true to the best of my knowledge and belief. Kansas Water Well Contractor's License No. 660 This Water Well Record was completed on (mo/day/yr) 6-5-00 under the business name of Goodman Water Well Drilling by (signature) Jack Good