


1 LOCATION OF WATER WELL: Fraction NE 1/4 SW 1/4 NW 1/4 Section Number 5 Township Number T 16 S Range Number R 12 E/W

Distance and direction from nearest town or city street address of well if located within city? 3-1/2 mi. N of Beaver, Kansas

2 WATER WELL OWNER: NCRA
RR#, St. Address, Box # : P. O. Box 1404 Board of Agriculture, Division of Water Resources
City, State, ZIP Code : McPherson, Kansas 67460 Application Number:

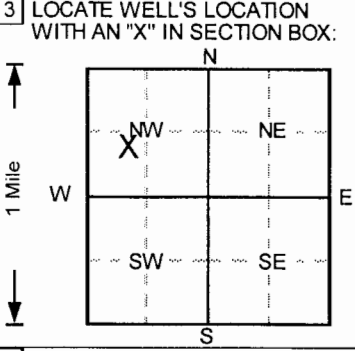

3 LOCATE WELL'S LOCATION WITH AN 'X' IN SECTION BOX:
4 DEPTH OF COMPLETED WELL 15 ft. ELEVATION:
Depth(s) Groundwater Encountered 1. ft. 2. ft. 3. ft.
WELL'S STATIC WATER LEVEL 11.5 ft. below land surface measured on mo/day/yr 12/16/2005
Pump test data: Well water was NA ft. after hours pumping gpm
Est. Yield NA gpm: Well water was ft. after hours pumping gpm
Bore Hole Diameter 8 in. to 15 ft., and in. to ft.
WELL WATER TO BE USED AS: 5 Public water supply 8 Air conditioning 11 Injection well
1 Domestic 3 Feedlot 6 Oil field water supply 9 Dewatering 12 Other (Specify below)
2 Irrigation 4 Industrial 7 Lawn and garden only 10 Monitoring well
Was a chemical/bacteriological sample submitted to Department? Yes.....No [X]; If yes, mo/day/yr sample was submitted
Water Well Disinfected? Yes No [X]

5 TYPE OF BLANK CASING USED:
1 Steel 2 PVC (circled) 3 RMP (SR) 4 ABS
5 Wrought iron 6 Asbestos-Cement 7 Fiberglass
8 Concrete tile 9 Other (specify below)
Blank casing diameter 2 in. to 5 ft., Dia in. to ft., Dia in. to ft.
Casing height above land surface 24 in., weight lbs./ft. Wall thickness or gauge No. Sch. 40

TYPE OF SCREEN OR PERFORATION MATERIAL
1 Steel 2 Brass 3 Stainless steel 4 Galvanized steel 5 Fiberglass 6 Concrete tile 7 PVC (circled) 8 RMP (SR) 9 ABS 10 Asbestos-cement 11 Other (specify) 12 None used (open hole)

SCREEN OR PERFORATION OPENINGS ARE:
1 Continuous slot 2 Louvered shutter 3 Mill slot (circled) 4 Key punched 5 Gauzed wrapped 6 Wire wrapped 7 Torch cut 8 Saw cut 9 Drilled holes 10 Other (specify) 11 None (open hole)

SCREEN-PERFORATED INTERVALS: From 5 ft. to 15 ft.
GRAVEL PACK INTERVALS: From 3 ft. to 15 ft.

6 GROUT MATERIAL: 1 Neat cement 2 Cement grout (circled) 3 Bentonite (circled) 4 Other
Grout intervals: From 0 ft. to 1 ft. From 1 ft. to 3 ft.

What is the nearest source of possible contamination:
1 Septic tank 2 Sewer lines 3 Watertight sewer lines 4 Lateral lines 5 Cess pool 6 Seepage pit 7 Pit privy 8 Sewage lagoon 9 Feedyard 10 Livestock pens 11 Fuel storage 12 Fertilizer storage 13 Insecticide storage 14 Abandoned water well 15 Oil well/Gas well 16 Other (specify below)

Table with columns: FROM, TO, LITHOLOGIC LOG, FROM, TO, PLUGGING INTERVALS.
LITHOLOGIC LOG entries: 0-11 Silt, clayey, with some lst. gravel, dry, Brown; 11-15 Silt, oil odor in cuttings, saturated, Gray.
PLUGGING INTERVALS entry: MW9, Abovegrade.

7 CONTRACTOR'S OR LANDOWNER'S CERTIFICATION: This water well was (1) constructed, (2) reconstructed, or (3) plugged under my jurisdiction and was completed on (mo/day/year) 12/16/2005 and this record is true to the best of my knowledge and belief.
Kansas Water Well Contractor's License No. 527. This Water Well Record was completed on (mo/day/yr) 1/3/06 under the business name of GeoCore, Inc. by (signature) Paul Bell