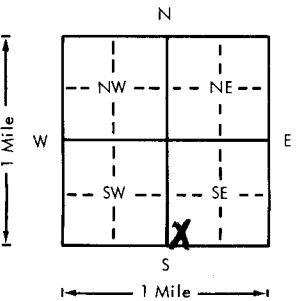


USE TYPEWRITER OR BALL POINT PEN-PRESS FIRMLY, PRINT CLEARLY.

WATER WELL RECORD
KSA 82a-1201-1215

Kansas Department of Health and Environment-Division of Environment
(Water well Contractors)
Topeka, Kansas 66620

1. Location of well:		County Barton	Fraction 1/4 5/2 1/4 1/4 1/4	Section number 30	Township number T 16 S	Range number R 12 E/W
2. Distance and direction from nearest town or city: Street address of well location if in city:			3. Owner of well: James Rief R.R. or street: R.R. City, state, zip code: Beaver KS.			
4. Locate with "X" in section below: Sketch map: 			6. Bore hole dia. 8 1/2 in. Completion date 6/5/79 Well depth 272 ft.			
5. Type and color of material			7. <input checked="" type="checkbox"/> Cable tool ___ Rotary ___ Driven ___ Dug ___ Hollow rod ___ Jetted ___ Bored ___ Reverse rotary			
			8. Use: <input checked="" type="checkbox"/> Domestic ___ Public supply ___ Industry ___ Irrigation ___ Air conditioning ___ Stock ___ Lawn ___ Oil field water ___ Other			
			9. Casing: Material ___ Height: Above or below Threaded ___ Welded ___ Surface 18 in. RMP ___ PVC <input checked="" type="checkbox"/> Weight 283 lbs./ft. Dia. 5 in. to 272 ft. depth Wall Thickness: inches or Dia. ___ in. to ___ ft. depth gage No. 265			
			10. Screen: Manufacturer's name M.P.I. Type PVC Dia. 5" Slot/gauze .025 Length 10' Set between 262 ft. and 272 ft. ft. and ___ ft. Gravel pack? <input checked="" type="checkbox"/> Size range of material 3/16" x 3/8"			
			11. Static water level: ___ no./day/yr. 250 ft. below land surface Date 6/5/79			
			12. Pumping level below land surfaces: ___ ft. after ___ hrs. pumping ___ g.p.m. ___ ft. after ___ hrs. pumping ___ g.p.m. Estimated maximum yield 25 g.p.m.			
			13. Water sample submitted: ___ no./day/yr. Yes <input checked="" type="checkbox"/> No ___ Date ___			
			14. Well head completion: <input checked="" type="checkbox"/> Pitless adapter 18 inches above grade			
			15. Well grouted? <input checked="" type="checkbox"/> With: <input checked="" type="checkbox"/> Neat cement ___ Bentonite ___ Concrete Depth: From 0 ft. to 15 ft. 250-260			
			16. Nearest source of possible contamination: ___ ft. 150' Direction East Type Beam Well disinfected upon completion? <input checked="" type="checkbox"/> Yes ___ No			
			17. Pump: ___ Not installed Manufacturer's name J+W Model number ___ HP 3/4 Volts 230 Length of drop pipe ___ ft. capacity 5 g.p.m. Type: <input checked="" type="checkbox"/> Submersible ___ Turbine ___ Jet ___ Reciprocating ___ Centrifugal ___ Other			
			(Use a second sheet if needed)			
18. Elevation:		19. Remarks:		20. Water well contractor's certification: This well was drilled under my jurisdiction and this report is true to the best of my knowledge and belief. Small Water Well 360 Business name License No. Address 95 South Ks Signed William S. Wagner 12/12/79 Authorized representative		
Topography: ___ Hill ___ Slope <input checked="" type="checkbox"/> Upland ___ Valley						

T 16 R 12 S 30 Sec 30 5/2 1/4 1/4 1/4

Forward the white, blue and pink copies to the Department of Health and Environment

Form WWC-5