


WATER WELL RECORD Form WWC-5 KSA 82a-1212

1 LOCATION OF WATER WELL:	Fraction	Section Number	Township Number	Range Number
County: BARTON	SE 1/4 SW 1/4 SW 1/4	2	T 16 S	R 14 E/W

Distance and direction from nearest town or city street address of well if located within city?
150' WEST OF SULLENS CREEK OFF NW 220 ROAD

2 WATER WELL OWNER:	Board of Agriculture, Division of Water Resources	
RR#, St. Address, Box #:	Application Number:	
City, State, ZIP Code:		

BOB DEFENBAUGH
RR2 2250 NORTH HWY 281
HOLINGTON, KS 67544

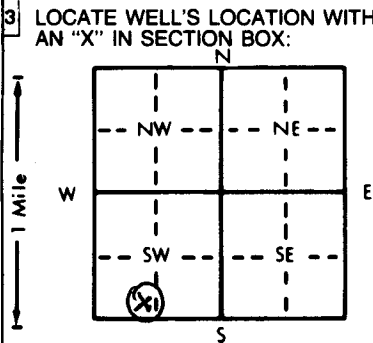

3 LOCATE WELL'S LOCATION WITH AN "X" IN SECTION BOX:	4 DEPTH OF COMPLETED WELL.	ELEVATION:
	19.0 ft.	
	Depth(s) Groundwater Encountered	ft. 2. ft. 3. ft.
	18 ft.	below land surface measured on mo/day/yr 3/19/99
	WELL'S STATIC WATER LEVEL	
	Pump test data: Well water was	ft. after hours pumping gpm
	Est. Yield gpm:	Well water was
	Bore Hole Diameter	8 in. to 19 in.
	WELL WATER TO BE USED AS:	
	1 Domestic	3 Feedlot
	2 Irrigation	4 Industrial
	5 Public water supply	8 Air conditioning
	6 Oil field water supply	9 Dewatering
	7 Lawn and garden only	10 Monitoring well
	11 Injection well	12 Other (Specify below)
	Was a chemical/bacteriological sample submitted to Department? Yes.....	No If yes, mo/day/yr sample was submitted
	Water Well Disinfected? Yes	No

5 TYPE OF BLANK CASING USED:	5 Wrought iron	8 Concrete tile	CASING JOINTS: Glued Clamped
1 Steel	3 RMP (SR)	6 Asbestos-Cement	9 Other (specify below)
2 PVC	4 ABS	7 Fiberglass	Welded
Blank casing diameter	2 in. to 19 in.	Dia	Threaded
Casing height above land surface	24" in., weight	lbs./ft. Wall thickness or gauge No.	Sch 40

TYPE OF SCREEN OR PERFORATION MATERIAL:	7 PVC	10 Asbestos-cement
1 Steel	3 Stainless steel	5 Fiberglass
2 Brass	4 Galvanized steel	6 Concrete tile
3 RMP (SR)	8 RMP (SR)	9 ABS
11 Other (specify)	12 None used (open hole)	
SCREEN OR PERFORATION OPENINGS ARE:	5 Gauzed wrapped	8 Saw cut
1 Continuous slot	6 Wire wrapped	9 Drilled holes
2 Louvered shutter	7 Torch cut	10 Other (specify)
3 Mill slot	11 None (open hole)	
SCREEN-PERFORATED INTERVALS:	From 14 ft. to 19 ft.	ft. to ft.
GRAVEL PACK INTERVALS:	From 12.50 ft. to 19 ft.	ft. to ft.

6 GROUT MATERIAL:	1 Neat cement	2 Cement grout	3 Bentonite	4 Other
Grout Intervals:	From 0 ft. to 2 ft.	From 2 ft. to 12.50 ft.	From ft. to ft.	
What is the nearest source of possible contamination:	1 Septic tank	4 Lateral lines	7 Pit privy	10 Livestock pens
2 Sewer lines	5 Cess pool	8 Sewage lagoon	11 Fuel storage	14 Abandoned water well
3 Watertight sewer lines	6 Seepage pit	9 Feedyard	12 Fertilizer storage	15 Oil well/Gas well
Direction from well?	WEST	How many feet?	200	

FROM	TO	LITHOLOGIC LOG	FROM	TO	PLUGGING INTERVALS
0	18	SILTY CLAY			
18	19	CLAY W/ LIMESTONE FRAGMENTS			

STONE JOB # 96380
 STONE SITE # 2000901

7 CONTRACTOR'S OR LANDOWNER'S CERTIFICATION: This water well was **(1) constructed**, (2) reconstructed, or (3) plugged under my jurisdiction and was completed on (mo/day/year) **3/19/99** and this record is true to the best of my knowledge and belief. Kansas Water Well Contractor's License No. **659A**. This Water Well Record was completed on (mo/day/yr) **3/23/99** under the business name of **STONE ENVIRONMENTAL** by (signature) **Paul T. Day**

INSTRUCTIONS: Use typewriter or ball point pen. PLEASE PRESS FIRMLY and PRINT clearly. Please fill in blanks, underline or circle the correct answers. Send top three copies to Kansas Department of Health and Environment, Bureau of Water, Topeka, Kansas 66620-0001. Telephone: 913-296-5545. Send one to WATER WELL OWNER and retain one for your records.