


1 LOCATION OF WATER WELL: Fraction SE Section Number 22 Township Number 16 Range Number 15 E/W

County: Barton ¼ ¼ ¼

Distance and direction from nearest town or city street address of well if located within city?
485 Brack St - Galatia, KS

2 WATER WELL OWNER: Dennis Funk
 RR #, St. Address, Box #: 485 Brack St. Board of Agriculture, Division of Water Resources
 City, State, ZIP Code: Galatia, KS Application Number: _____

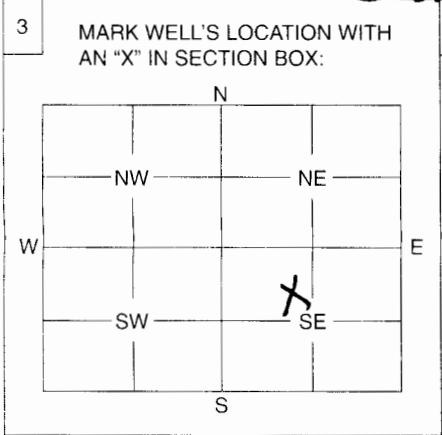

4 DEPTH OF WELL 30'6" ft.
 WELL'S STATIC WATER LEVEL 26'4" ft.

WELL WAS USED AS:

1 Domestic	5 Public Water Supply	9 Dewatering
2 Irrigation	6 Oil Field Water Supply	10 Monitoring Well
3 Feedlot	7 Domestic (Lawn & Garden)	11 Injection Well
4 Industrial	8 Air Conditioning	12 Other

Was a chemical / bacteriological sample submitted to Department? Yes No X.....
 If yes, mo/day/yr sample was submitted

Water Well Disinfected: Yes X No

5 TYPE OF BLANK CASING USED:

<u>1 Steel</u>	3 RMP (SR)	5 Wrought	7 Fiberglass	9 Other (Specify below)
2 PVC	4 ABS	6 Asbestos-Cement	8 Concrete Tile	

Blank casing diameter 5" in. Was casing pulled? Yes X No If yes, how much 3'.....
 Casing height above or below land surface 36 in.

6 GROUT PLUG MATERIAL: 1 Neat cement 2 Cement grout 3 Bentonite 4 Other

Grout Plug Intervals: From 30'6" ft. to 3' ft., From ft. to ft., From to ft.

What is the nearest source of possible contamination:

1 Septic tank	6 Seepage pit	11 Fuel storage	16 Other (specify below)
2 Sewer lines	7 Pit privy	12 Fertilizer storage	
3 Watertight sewer lines	8 Sewage lagoon	13 Insecticide storage	
<u>4 Lateral lines</u>	9 Feedyard	14 Abandoned water well	
5 Cess pool	10 Livestock pens	15 Oil well/Gas well	

Direction from well? N How many feet? 15'

FROM	TO	PLUGGING MATERIALS
<u>30'6"</u>	<u>3'</u>	<u>Bentonite Powder</u>
<u>3'</u>	<u>2'</u>	<u>Neat Cement</u>
<u>2'</u>	<u>0'</u>	<u>Backfilled Compacted Soil</u>

7 CONTRACTOR'S OF LANDOWNER'S CERTIFICATION: This water well was plugged under my jurisdiction and was completed on (mo/day/year) and this record is true to the best of my knowledge and belief. Kansas Water Well Contractor's License No. 11127107 This Water Well Record was completed on (mo/day/year) under the business name of by (signature) Dennis S. Funk

INSTRUCTIONS: Use typewriter or ball point pen. Please press firmly and print clearly. Please fill in blanks, underline or circle the correct answers. Send top three copies to Kansas Department of Health and Environment, Bureau of Water, Geology Section, 1000 SW Jackson St., Ste. 420, Topeka, Kansas 66612-1367. Telephone: 785/296-5522. Send one to Water Well Owner and retain one for your records.