

WATER WELL PLUGGING RECORD Form WWC-5P

KSA 82a-1212

ID NO.

G-1

1 LOCATION OF WATER WELL: County: Russell	Fraction ¼ NW ¼ SW ¼ NW ¼	Section Number 32	Township Number T 13 S	Range Number 15 <input type="checkbox"/> E <input checked="" type="checkbox"/> W
---	------------------------------	----------------------	---------------------------	---

Street/Rural Address of Well Location; if unknown, distance & direction from nearest town or intersection: If at owner's address, check here ☒

Global Positioning Systems (GPS) information:

Latitude: 38.87989 (in decimal degrees)

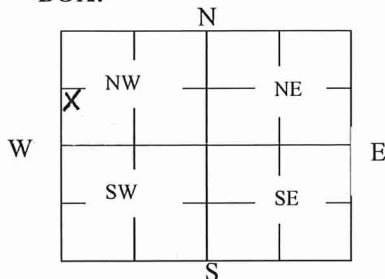
Longitude: -99.02069 (in decimal degrees)

Elevation: ~1914

Horizontal Datum: ☒ WGS84, ☐ NAD83, ☐ NAD27

Collection Method:

2 WATER WELL OWNER: Weigel Oil Company
RR#, St. Address, Box #: E Highway 40
City, State ZIP Code: Gorham, KS 67640

☐ GPS unit (Make/Model):☒ Digital Map/Photo, ☐ Topographic Map, ☐ Land SurveyEst. Accuracy: ☒ < 3 m, ☐ 3-5 m, ☐ 5-15 m, ☐ > 15 m**3 MARK WELL'S LOCATION WITH AN "X" IN SECTION BOX:****4 DEPTH OF WELL** 25.31 **ft.**WELL'S STATIC WATER LEVEL 18.12 **ft**

WELL WAS USED AS:

☐ Domestic
☐ Irrigation
☐ Feedlot
☐ Industrial

☐ Public Water Supply
☐ Oil Field Water Supply
☐ Domestic (Lawn & Garden)
☐ Air Conditioning

☒ Dewatering
☐ Monitoring
☐ Injection Well
☐ Other
Was a chemical/bacteriological sample submitted to Department? Yes ☐ No ☒**5 TYPE OF BLANK CASING USED:**
☐ Steel
☒ PVC

☐ RMP (SR)
☐ ABS

☐ Wrought
☐ Asbestos-Cement

☐ Fiberglass
☐ Concrete Tile
☐ Other (Specify below)Blank casing diameter 2 in. Was casing pulled? Yes ☒ No ☐ If yes, how much 3'

Casing height above or below land surface Flush in.

6 GROUT PLUG MATERIAL: ☐ Neat cement ☐ Cement grout ☒ Bentonite ☐ Other

Grout Plug Intervals: From 3 ft. to 25.31 ft., From ft. to ft., From ft. to ft.

What is the nearest source of possible contamination:

☐ Septic tank
☐ Sewer lines
☐ Watertight sewer lines
☐ Lateral lines
☐ Cess pool

☐ Seepage pit
☐ Pit privy
☐ Sewage lagoon
☐ Feedyard
☐ Livestock pens

☐ Fuel storage
☐ Fertilizer storage
☐ Insecticide storage
☐ Abandoned water well
☐ Oil well/Gas well
☒ Other (specify below)
Contaminated siteDirection from well?
How many feet?

FROM	TO	PLUGGING MATERIALS	FROM	TO	PLUGGING MATERIALS
0	3	Topsoil			
3	25.31	Bentonite			
					Well #G-1

7 CONTRACTOR'S OR LANDOWNER'S CERTIFICATION: This water well was plugged under my jurisdiction and was completed on (mo/day/year) 12/19/2024 and this record is true to the best of my knowledge and belief. Kansas Water Well Contractor's License No. 527. This Water Well Record was completed on (mo/day/year) 12/26/2024 under the business name of GeoCore, LLC by (signature) *Jon Miller*

Send one white copy to Kansas Department of Health & Environment, Geology Section, 1000 SW Jackson Street, Ste. 420, Topeka, KS 66612-1367. Send one copy to WATER WELL OWNER and retain one for your records.

Visit us at <http://www.kdheks.gov/waterwell/index.html> Telephone 785-296-5524.

KSA82a-1212

Revised 1/20/2015